

# MISSISSIPPI DEPARTMENT OF NATURAL RESOURCES

Bureau of Land and Water Resources

P.O. Box 10631

Jackson, Mississippi 39209

**WATER WELL DRILLERS LOG**

COUNTY WELL LOCATED <b>JACKSON</b>	
WELL NUMBER <b>N 2363</b>	CODED
DATE WELL COMPLETED <b>12-8-86</b>	

PERMIT NUMBER
NAME OF DRILLING FIRM <b>Coast Water Well</b>

NAME & MAILING ADDRESS OF LANDOWNER <b>Allen Fisher</b>		
<b>Magnolia Dr.</b>		
<b>Ocean Springs</b>		
WELL LOCATION: SEC	TOWNSHIP	RANGE
<b>3</b>	<b>8 S</b>	<b>8 W</b>
DISTANCE <b>1/2</b> Miles	DIRECTION <b>SE</b>	NEAREST TOWN <b>Ocean Springs</b>
OTHER LANDMARK		
WELL PURPOSE: Home, Irrigation, Municipal, Industrial, Fish Pond, etc. <b>home.</b>		

<b>PUMP DATA</b>		
PUMP TYPE (Circle One): Submersible, Turbine, <b>Jet</b> Flowing Well, Other (Describe) _____		
POWER TYPE (Circle One): Electric, Tractor, Diesel, Gasoline, Butane, Other (Describe) _____		
Pump Capacity (GPM) <b>24</b>	No. of Stages <b>2</b>	Setting Depth <b>FT.</b>
PUMP TEST		
Well yielded _____ GPM with a drawdown of _____ ft. after _____ hours of pumping		

<b>WELL DATA</b>		
Well Depth <b>88 78</b>	Casing Diameter (In.) <b>2"</b>	Casing Length (Ft.) <b>168'</b>
Type of Casing <b>PVC</b>	Hole Depth <b>83'</b>	Depth to Static Water Level <b>14'</b>
TYPE OF COMPLETION: (Circle One or More): Gravel Packed, Underreamed, Telescoped, <b>Natural Development</b> , Open Hole, Other		
Top of Lap Pipe or Reduction in Casing		
FEET	IF TELESCOPED OR MORE THAN ONE SCREEN: USE BACK PAGE	

<b>LOG DATA</b>	
TYPE OF LOG RUN (Circle One): Electric, Gamma Ray, Density, Sonic, Neutron, Other (Describe) _____	
Name of Organization Running Log	

<b>SCREEN DATA</b>		
Diameter - Inches <b>2"</b>	Length - Feet <b>10'</b>	Slot Size - Inches <b>.008</b>
Screen Type <b>PVC</b>	Depth to Bottom - Feet <b>78'</b>	

<b>GEOLOGIC DATA (Office Use Only)</b>			
Surface Elev.	Geologic Unit	Unit Thickness	Depth to Top
Subs. SWL	Date	Analysis	Aquifer Test


Driller's Remarks

DESCRIPTION OF FORMATIONS ENCOUNTERED	FROM	TO	FORMATIONS (Continued)	FROM	TO
<b>Brown Clay</b>	<b>0</b>	<b>5</b>	<div style="border: 1px solid black; padding: 5px; display: inline-block;"> <b>PROCESSED</b>  <b>MAY 21 1987</b> </div>		
<b>White Coarse Sand</b>	<b>5</b>	<b>10</b>			
<b>Blue Clay</b>	<b>10</b>	<b>55</b>			
<b>White Coarse Sand</b>	<b>55</b>	<b>78</b>			
<b>Blue Clay</b>	<b>78</b>	<b>83</b>			

IF MORE SPACE IS NEEDED, USE BACK

If well telescopes please sketch and show depths.

GROUND LEVEL

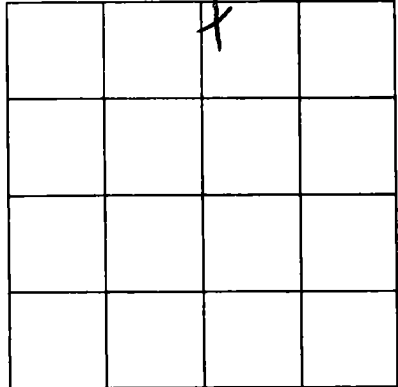

SECTION 3

Please indicate well location X.

ADDITIONAL INFORMATION

If more than one screen, show location of each on sketch.