

**MISSISSIPPI DEPARTMENT OF NATURAL RESOURCES**  
Bureau of Land and Water Resources

COUNTY WELL LOCATED  
**Jackson**

WELL NUMBER CODED  
**N 2304**

DATE WELL COMPLETED  
**12-15-86**

PERMIT NUMBER

NAME OF DRILLING FIRM  
**Coastwater well**

P.O. Box 10631  
Jackson, Mississippi 39209  
**WATER WELL DRILLERS LOG**

NAME & MAILING ADDRESS OF LANDOWNER  
**Big Ridge Animal Clinic**  
**7405 Tucker Rd**  
**Ocean Springs ms**

WELL LOCATION: SEC **12** TOWNSHIP **7** RANGE **9**

DISTANCE **1** Miles DIRECTION **NE** NEAREST TOWN **DIBERVILLE**

OTHER LANDMARK

WELL PURPOSE: Home, Irrigation, Municipal, Industrial, Fish Pond, etc.  
**vet. office**

**PUMP DATA**

PUMP TYPE (Circle One):  
Submersible, Turbine, Jet, Flowing Well,  
Other (Describe) \_\_\_\_\_

POWER TYPE (Circle One):  
Electric, Tractor, Diesel, Gasoline, Butane,  
Other (Describe) \_\_\_\_\_

Pump Capacity (GPM) **13** No. of Stages **5** Setting Depth **120** FT.

PUMP TEST

Well yielded \_\_\_\_\_ GPM with  
a drawdown of \_\_\_\_\_ ft.  
after \_\_\_\_\_ hours of pumping

**WELL DATA**

Well Depth **445** Casing Diameter (In.) **4" x 2"** Casing Length (Ft.) **4" - 260**  
**450ft** **2" - 165'**

Type of Casing **PVC** Hole Depth **450'** Depth to Static Water Level **63ft**

TYPE OF COMPLETION: (Circle One or More):  
Gravel Packed, Underreamed, Telescoped,  
Natural Development, Open Hole, Other

Top of Lap Pipe or Reduction in Casing  
**30** FEET IF TELESCOPED OR MORE THAN ONE SCREEN: USE BACK PAGE

**LOG DATA**

TYPE OF LOG RUN (Circle One):  
Electric, Gamma Ray, Density, Sonic, No Log Run,  
Other (Describe) \_\_\_\_\_

Name of Organization Running Log

**SCREEN DATA**

Diameter - Inches **2"** Length - Feet **20'** Slot Size - Inches **.008**

Screen Type **PVC** Depth to Bottom - Feet **445ft**

**GEOLOGIC DATA (Office Use Only)**

Surface Elev.	Geologic Unit	Unit Thickness	Depth to Top
Subs. SWL	Date	Analysis	Aquifer Test

Driller's Remarks

DESCRIPTION OF FORMATIONS ENCOUNTERED	FROM	TO
White Coarse Sand	0	14
Blue Clay	14	29
White Coarse Sand	29	58
Blue Clay w/ streaks of sand	58	90
Blue Clay	90	130
Gray med sand	130	145
Blue Clay	145	329
Blue Gray med sand	329	344
Blue Clay	344	391
Gray Coarse sand	391	460

FORMATIONS (Continued)	FROM	TO
<b>Blue Clay</b>	<b>460</b>	<b>465</b>


**MAY 21 1987**

Department of Natural Resources  
Bureau of Land & Water Resources

IF MORE SPACE IS NEEDED, USE BACK

If well telescopes please sketch and show depths.

GROUND LEVEL

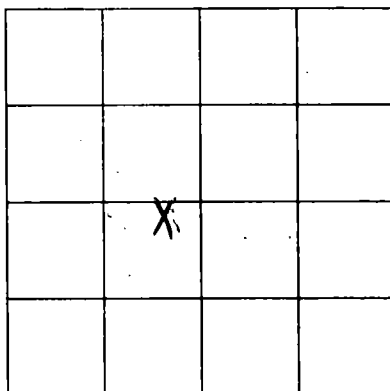

SECTION 12

Please indicate well location X.

ADDITIONAL INFORMATION

If more than one screen, show location of each on sketch.