

# MISSISSIPPI DEPARTMENT OF NATURAL RESOURCES

Bureau of Land and Water Resources

P.O. Box 10631

Jackson, Mississippi 39209

## WATER WELL DRILLERS LOG

COUNTY WELL LOCATED <b>Jackson</b>
WELL NUMBER <b>N7309</b>
DATE WELL COMPLETED <b>4-13-87</b>

PERMIT NUMBER
NAME OF DRILLING FIRM <b>Coast Water Well Service</b>

NAME & MAILING ADDRESS OF LANDOWNER <b>Zack Martin</b>			
<b>103 Shady Oaks</b>			
<b>Ocean Springs Ms</b>			
WELL LOCATION: SEC	TOWNSHIP	RANGE	
<b>22</b>	<b>7<sup>N</sup></b>	<b>8<sup>E</sup></b>	
DISTANCE	DIRECTION	NEAREST TOWN	
<b>—</b> Miles	<b>N</b> of	<b>O.S</b>	
OTHER LANDMARK			
WELL PURPOSE: Home, Irrigation, Municipal, Industrial, Fish Pond, etc. <b>Law care</b>			

<b>PUMP DATA</b>		
PUMP TYPE (Circle One): Submersible, Turbine, <b>JET</b> <input checked="" type="radio"/> Flowing Well, Other (Describe) _____		
POWER TYPE (Circle One): <b>Electric</b> <input checked="" type="radio"/> Tractor, Diesel, Gasoline, Butane, Other (Describe) _____		
Pump Capacity (GPM) <b>12</b>	No. of Stages <b>2</b>	Setting Depth <b>—</b> FT.
PUMP TEST		
Well yielded _____ GPM with a drawdown of _____ ft. after _____ hours of pumping		

<b>WELL DATA</b>		
Well Depth <b>75'</b>	Casing Diameter (In.) <b>2"</b>	Casing Length (Ft.) <b>65'</b>
Type of Casing <b>PVC</b>	Hole Depth <b>75'</b>	Depth to Static Water Level <b>12'</b>
TYPE OF COMPLETION: (Circle One or More): Gravel Packed, Underreamed, Telescoped, <b>Natural Development</b> <input checked="" type="radio"/> Open Hole, Other _____		
Top of Lap Pipe or Reduction in Casing		
FEET	IF TELESCOPED OR MORE THAN ONE SCREEN: USE BACK PAGE	

<b>LOG DATA</b>	
TYPE OF LOG RUN (Circle One): Electric, Gamma Ray, Density, Sonic, Neutron, Other (Describe) _____	
Name of Organization Running Log <b>No Log Run</b> <input checked="" type="radio"/>	


<b>SCREEN DATA</b>		
Diameter - Inches <b>2"</b>	Length - Feet <b>10'</b>	Slot Size - Inches <b>.008</b>
Screen Type <b>PVC</b>		Depth to Bottom, Feet <b>75'</b>

<b>GEOLOGIC DATA (Office Use Only)</b>			
Surface Elev.	Geologic Unit	Unit Thickness	Depth to Top
Subs. SWL	Date	Analysis	Aquifer Test
Driller's Remarks			

DESCRIPTION OF FORMATIONS ENCOUNTERED	FROM	TO	FORMATIONS (Continued)	FROM	TO
<b>Top Soil</b>	<b>0</b>	<b>2</b>	<b>DRILLING</b> <b>LOG</b>		
<b>Blue Clay</b>	<b>2</b>	<b>60</b>			
<b>Gray Coastal Sand</b>	<b>60</b>	<b>75</b>			
			<b>MAY 21 1987</b>		
			<b>Department of Natural Resources</b> <b>Bureau of Land &amp; Water Resources</b>		
IF MORE SPACE IS NEEDED, USE BACK					

If well telescopes please sketch and show depths.

GROUND LEVEL

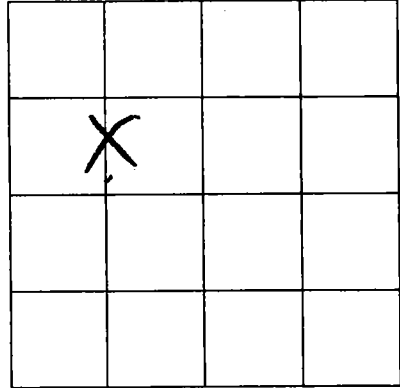

SECTION 22

Please indicate well location X.

ADDITIONAL INFORMATION

If more than one screen, show location of each on sketch.