

10c -

MISSISSIPPI DEPARTMENT OF NATURAL RESOURCES
Bureau of Land and Water Resources

P.O. Box 10631
Jackson, Mississippi 39209
WATER WELL DRILLERS LOG

COUNTY WELL LOCATED <i>Jackson</i>	WELL NUMBER <i>N 2312</i>	CODED	PERMIT NUMBER
NAME OF DRILLING FIRM <i>Coast Water Well Serv.</i>			
DATE WELL COMPLETED <i>8-7-87</i>			

NAME & MAILING ADDRESS OF LANDOWNER <i>Robert Stanley</i> <i>8401 Vanna St.</i> <i>Biloxi, Mo. 39532</i>			
WELL LOCATION:	SEC	TOWNSHIP	RANGE
	<i>3</i>	<i>70</i>	<i>9</i>
DISTANCE	DIRECTION	NEAREST TOWN	
<i>2</i> Miles	<i>N</i>	<i>DIBERVILLE</i>	
OTHER LANDMARK			
WELL PURPOSE: Home, Irrigation, Municipal, Industrial, Fish Pond, etc. <i>home</i>			

PUMP DATA		
PUMP TYPE (Circle One): Submersible, Turbine, <u>Jet</u> Flowing Well, Other (Describe) _____		
POWER TYPE (Circle One): <u>Electric</u> , Tractor, Diesel, Gasoline, Butane, Other (Describe) _____		
Pump Capacity (GPM)	No. of Stages	Setting Depth
<i>5'</i>	<i>2</i>	<i>—</i> FT.
PUMP TEST		
Well yielded <i>—</i> GPM with a drawdown of <i>—</i> ft. after <i>—</i> hours of pumping		

WELL DATA		
Well Depth	Casing Diameter (In.)	Casing Length (Ft.)
<i>390'</i>	<i>2"</i>	<i>375'</i>
Type of Casing	Hole Depth	Depth to Static Water Level
<i>PVC</i>	<i>390'</i>	<i>70'</i>
TYPE OF COMPLETION: (Circle One or More): <u>Natural Development</u> , Gravel Packed, Underreamed, Telescoped, Open Hole, Other (Describe) _____		
Top of Lap Pipe or Reduction in Casing		
FEET	IF TELESCOPED OR MORE THAN ONE SCREEN: USE BACK PAGE	

LOG DATA	
TYPE OF LOG RUN (Circle One): Electric, Gamma Ray, Density, Sonic, Neutron, <u>No Log Run</u> , Other (Describe) _____	
Name of Organization Running Log	

SCREEN DATA		
Diameter - Inches	Length - Feet	Slot Size - Inches
<i>2"</i>	<i>10'</i>	<i>.008</i>
Screen Type	Depth to Bottom - Feet	
<i>PVC</i>	<i>385'</i>	

GEOLOGIC DATA (Office Use Only)			
Surface Elev.	Geologic Unit	Unit Thickness	Depth to Top
Subs. SWL	Date	Analysis	Aquifer Test

Driller's Remarks

RECEIVED

DESCRIPTION OF FORMATIONS ENCOUNTERED	FROM	TO	FORMATIONS (Continued)	FROM	TO
<i>Top Soil</i>	<i>0</i>	<i>1</i>			
<i>Yellow Clay</i>	<i>1</i>	<i>13</i>			
<i>White Coarse Sand</i>	<i>13</i>	<i>28</i>			
<i>Blue Clay w/ (streak) Sand</i>	<i>28</i>	<i>70</i>			
<i>Med. Gray Sand</i>	<i>70</i>	<i>95</i>			
<i>Blue Clay</i>	<i>95</i>	<i>365</i>			
<i>Dark Med. Sand</i>	<i>365</i>	<i>385</i>			
<i>Blue Clay</i>	<i>385</i>	<i>390</i>			


SEP 21 1987

Department of Natural Resources
Bureau of Land & Water Resources

IF MORE SPACE IS NEEDED, USE BACK

If well telescopes please sketch and show depths.

GROUND LEVEL

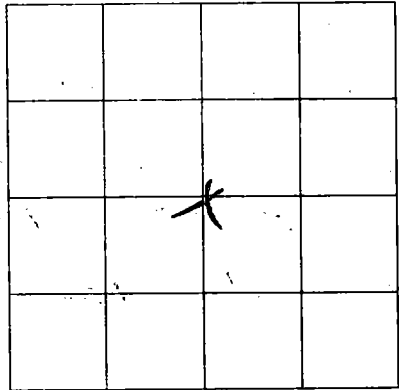

SECTION 3

Please indicate well location X!

ADDITIONAL INFORMATION

A series of horizontal lines for writing additional information.

[Faint, illegible text or stamp]

If more than one screen, show location of each on sketch.