

add. loc

MISSISSIPPI DEPARTMENT OF NATURAL RESOURCES  
Bureau of Land and Water Resources

P.O. Box 10631  
Jackson, Mississippi 39209  
WATER WELL DRILLERS LOG

COUNTY WELL LOCATED
Jackson
WELL NUMBER CODED
N 2314
DATE WELL COMPLETED
6-24-87

PERMIT NUMBER
NAME OF DRILLING FIRM
Coast Water Well Service

NAME & MAILING ADDRESS OF LANDOWNER
Floyd Fountain
16108 Quave St
N Biloxi MS
WELL LOCATION: SEC TOWNSHIP RANGE
10 7 9
DISTANCE DIRECTION NEAREST TOWN
1/2 IN Miles of DIBERVILLE
OTHER LANDMARK
WELL PURPOSE: Home, Irrigation, Municipal, Industrial, Fish Pond, etc.
home

PUMP DATA
PUMP TYPE (Circle One):
Submersible, Turbine, <u>Jet</u> Flowing Well, Other (Describe)
POWER TYPE (Circle One):
<u>Electric</u> , Tractor, Diesel, Gasoline, Butane, Other (Describe)
Pump Capacity (GPM) No. of Stages Setting Depth
12 2 — FT.
PUMP TEST
Well yielded — GPM with a drawdown of — ft. after — hours of pumping

WELL DATA
Well Depth Casing Diameter (In.) Casing Length (Ft.)
272' 2" 265'
Type of Casing Hole Depth Depth to Static Water Level
PVC 277' 32'
TYPE OF COMPLETION: (Circle One or More):
Gravel Packed, Underreamed, Telescoped, Natural Development, Open Hole, Other
<u>Natural Development</u>
Top of Lap Pipe or Reduction in Casing
FEET IF TELESCOPED OR MORE THAN ONE SCREEN: USE BACK PAGE

LOG DATA
TYPE OF LOG RUN (Circle One):
Electric, Gamma Ray, Density, Sonic, Neutron, Other (Describe)
<u>No Log Run.</u>
Name of Organization Running Log

SCREEN DATA
Diameter - Inches Length - Feet Slot Size - Inches
2 7' .008
Screen Type Depth to Bottom - Feet
PVC 272'

GEOLOGIC DATA (Office Use Only)
Surface Elev. Geologic Unit Unit Thickness Depth to Top
Subs. SWL Date Analysis Aquifer Test
Driller's Remarks


DESCRIPTION OF FORMATIONS ENCOUNTERED	FROM	TO
Top Soil	0	2
Red Clay	2	16
White Coarse Sand & Gravel	16	42
Blue Clay	42	103
Gray Med Sand	103	115
Blue Clay	115	253
Gray Fine Sand	253	264
Gray Med Sand	264	272
Blue Clay	272	277

FORMATIONS CONTAINED
<b>RECEIVED</b>
SEP 21 1987
Department of Natural Resources Bureau of Land & Water Resources
IF MORE SPACE IS NEEDED, USE BACK

If well telescopes please sketch and show depths.

GROUND LEVEL

Vertical column for sketching well telescopes and depths. Includes a horizontal line at the top labeled "GROUND LEVEL".

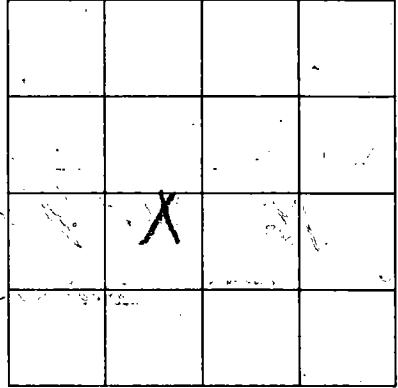

SECTION 16

Please indicate well location X.

ADDITIONAL INFORMATION

Lined area for providing additional information. Contains 16 horizontal lines below the "ADDITIONAL INFORMATION" header.

REVISIONS

108

...

If more than one screen, show location of each on sketch.