

MISSISSIPPI DEPARTMENT OF NATURAL RESOURCES
Bureau of Land and Water Resources

P.O. Box 10631

Jackson, Mississippi 39209
WATER WELL DRILLERS LOG

COUNTY WELL LOCATED <i>Jackson</i>
WELL NUMBER CODED <i>N 2311</i>
DATE WELL COMPLETED <i>1-28-87</i>

PERMIT NUMBER
NAME OF DRILLING FIRM <i>Coast water well</i>

NAME & MAILING ADDRESS OF LANDOWNER <i>Dennis Peristeras</i>		
<i>6619 Omaha St</i>		
<i>Biloxi MS 39532</i>		
WELL LOCATION: SEC	TOWNSHIP	RANGE
<i>16</i>	<i>7</i>	<i>9</i> (W)
DISTANCE	DIRECTION	NEAREST TOWN
<i>IN</i> Miles	<i>—</i>	of <i>ST. MARTIN</i>
OTHER LANDMARK		
WELL PURPOSE: Home, Irrigation, Municipal, Industrial, Fish Pond, etc. <i>Home</i>		

PUMP DATA		
PUMP TYPE (Circle One): Submersible, Turbine, Jet, Flowing Well, Other (Describe) _____		
POWER TYPE (Circle One): Electric, Tractor, Diesel, Gasoline, Butane, Other (Describe) _____		
Pump Capacity (GPM)	No. of Stages	Setting Depth FT.
PUMP TEST		
Well yielded _____ GPM with a drawdown of _____ ft. after _____ hours of pumping		

WELL DATA		
Well Depth <i>430'</i>	Casing Diameter (In.) <i>2"</i>	Casing Length (Ft.) <i>410</i>
Type of Casing <i>PVC</i>	Hole Depth <i>435'</i>	Depth to Static Water Level <i>45'</i>
TYPE OF COMPLETION: (Circle One or More): Gravel Packed, Underreamed, Telescoped, Natural Development , Open Hole, Other		
Top of Lap Pipe or Reduction in Casing FEET <input type="checkbox"/> IF TELESCOPED OR MORE THAN ONE SCREEN: USE BACK PAGE		

LOG DATA	
TYPE OF LOG RUN (Circle One): Electric, Gamma Ray, Density, Sonic, Neutron, Other (Describe) _____	
Name of Organization Running Log	


SCREEN DATA		
Diameter - Inches <i>2"</i>	Length - Feet <i>20'</i>	Slot Size - Inches <i>.008</i>
Screen Type <i>PVC</i>	Depth to Bottom - Feet <i>430'</i>	

GEOLOGIC DATA (Office Use Only)	
Surface Elevation	Depth to Top
Subs. SWL	Analysis
Driller's Remarks SEP 21 1987	
Department of Natural Resources Bureau of Land & Water Resources	

DESCRIPTION OF FORMATIONS ENCOUNTERED	FROM	TO	FORMATIONS (Continued)	FROM	TO
<i>Top Soil</i>	<i>0</i>	<i>2</i>	<i>Pea Gravel</i>	<i>395</i>	<i>400</i>
<i>White Coarse Sand</i>	<i>2</i>	<i>5</i>	<i>Blue Clay</i>	<i>400</i>	<i>402</i>
<i>Brown Clay</i>	<i>5</i>	<i>10</i>	<i>Gray Coarse Sand</i>	<i>402</i>	<i>430</i>
<i>White Coarse Sand</i>	<i>10</i>	<i>14</i>	<i>Gray Coarse Sand</i>	<i>430</i>	<i>435</i>
<i>Blue Clay</i>	<i>14</i>	<i>16</i>	<i>+ Fresh.</i>		
<i>White Coarse Sand</i>	<i>16</i>	<i>35</i>			
<i>Blue Clay</i>	<i>35</i>	<i>115</i>			
<i>Fine Gray Sand</i>	<i>115</i>	<i>130</i>			
<i>Blue Clay</i>	<i>130</i>	<i>140</i>			
<i>Fine Gray Sand</i>	<i>140</i>	<i>150</i>			
<i>Blue Clay</i>	<i>150</i>	<i>395</i>			

IF MORE SPACE IS NEEDED, USE BACK

If well telescopes please sketch and show depths.

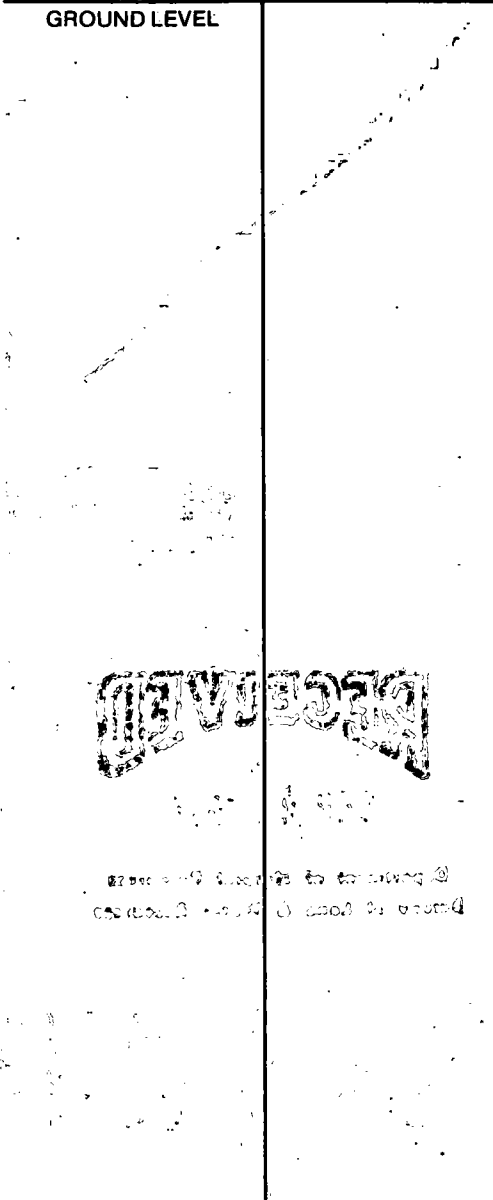

			X

SECTION 16

Please indicate well location X.

ADDITIONAL INFORMATION

If more than one screen, show location of each on sketch.