

JACKSON  
N 2323

MISSISSIPPI  
BOARD OF WATER COMMISSIONERS  
416 North State Street  
Jackson, Mississippi 39201  
WATER WELL DRILLERS LOG

1 SEPT 1987 COATEC (DRILLING CO.) JACKSON  
date well completed firm name county well located

LANDOWNER: J. A. WILLIAMS 1423 DILLER Rd OCEAN SPRINGS Ms 39564 (mailing address)	description of formations encountered	from	to
WELL LOCATION: sec. 21 T 7 N R 8 E S miles East of DOWNTOWN OCEAN SPRINGS (distance) (direction) (nearest town)	TOP SOIL	0	2'
WELL PURPOSE: YARD WELL (home, irrigation, municipal, industrial)	COURSE WHITE SAND	2'	6'
WELL COMPLETION DATA: (1) diameter (inches) 2" (2) total depth (feet) 77' (3) static water level (feet) 10' below top of ground. (4) casing PVC, 67' (material) (depth) 2" (size) If telescope see back. (5) screen 10' (length), 77' to 67' (depth to top) 2" (size), WRAPPED PVC (material) (6) pump 1/2 HP (HP), 216 GPM (yield gpm) Electric (type power) (7) electric log No (yes or no) N/A (organization running log) (8) how well bottom plugged FLOAT BALL BACK WASH VALVE	FINE GREY CLAY + SAND	6'	7'
	COURSE SAND - HIGH FE CONTENT	7'	10'
	FINE GREY CLAY + SAND	10'	12'
	FINE SAND + MUD (DARK GREY)	12'	18'
	BLUE GUMBO MUD	18'	57'
	FINE SALT + PEPPER SAND	57'	63'
	COURSE SALT + PEPPER SAND	63'	81'
	BLUE GUMBO MUD	81'	84' →
DRILLERS REMARKS: CASING GROTTED + CAPPED WITH CONCRETE AROUND CASING			


RECEIVED

OCT 15 1987

Department of Natural Resources  
Bureau of Land & Water Resources

If well telescopes please sketch and show depths.

GROUND LEVEL

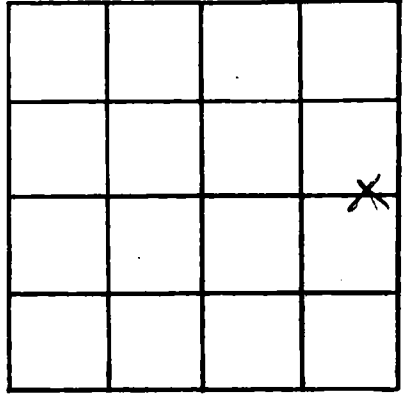

SECTION 21

Please indicate well location X.

ADDITIONAL INFORMATION

If more than one screen, show locations of each on sketch.