

JACKSON
N 2324

MISSISSIPPI
BOARD OF WATER COMMISSIONERS
416 North State Street
Jackson, Mississippi 39201

WATER WELL DRILLERS LOG

12 SEP 1987 PORTER (DRILLING CO.) JACKSON
date well completed firm name county well located

LANDOWNER: CHESTER ABBOTT 606 DOGWOOD Rd DEAN SPRINGS, MS 39564 (mailing address)	description of formations encountered	from	to
WELL LOCATION: sec. 29 T 7 N R 8 E 1/2 miles EAST of DOWNTOWN DEAN SPRINGS (distance) (direction) (nearest town)			
WELL PURPOSE: YARD WELL (home, irrigation, municipal, industrial)	TOP SOIL	0'	1'
WELL COMPLETION DATA: (1) diameter (inches) 2" (2) total depth (feet) 66' (3) static water level (feet) 21' below top of ground. (4) casing PVC (material), 56' (depth), 2" (size) If telescope see back. (5) screen 10' (length), 66' to 56' (depth to top), 2" (size), WRAPPED PVC (material) (6) pump 1/2 (HP), 12 (yield gpm), Electric (type power) (7) electric log No (yes or no), N/A (organization running log) (8) how well bottom plugged FLOST BALL BACK WASH VALVE	RED CLAY	1'	3'
	WHITE SAND (COURSE)	3'	21'
	GREY MUD & FINE SAND	21'	40'
	GREY MUD	40'	47'
	FINE GREY SAND	47'	51'
	MUD & SHELL	51'	52'
	COURSE GREY SAND	52'	68'
	SUMMY MUD	68'	70'
DRILLERS REMARKS: CASEING GRouted IN WITH NEAT CEMENT - TOP CAPPED WITH 2 1/2' X 3' CONCRETE SLAB			


RECEIVED

OCT 15 1987

Department of Natural Resources
Bureau of Land & Water Resources

If well telescopes please sketch and show depths.

GROUND LEVEL

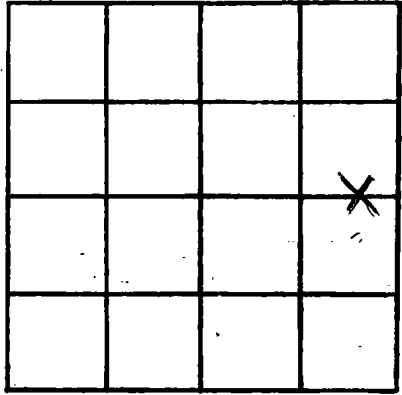

SECTION 29

Please indicate well location X.

ADDITIONAL INFORMATION

If more than one screen, show locations of each on sketch.