

MISSISSIPPI DEPARTMENT OF NATURAL RESOURCES

Bureau of Land and Water Resources

Southport Mall

P.O. Box 10631

Jackson, Mississippi 39209

WATER WELL DRILLERS LOG

JACKSON
N 2326

7-11-87 19__
date well completed

R. J. Moore
firm name

JACKSON
HARRISON
county well located

LANDOWNER: <u>D.A. Wade</u> <u>LORRAINE CIRLO</u>	description of formations encountered	from	to
<u>ST MARTIN, Bilalot Ms</u> (mailing address)	<u>Top Soil</u>	<u>0</u>	<u>20</u>
WELL LOCATION: sec <u>11</u> T <u>7</u> N R <u>9</u> E <u>SAINT MARTIN COMMUNITY</u> (distance) miles (direction) of (nearest town)	<u>Orange</u> <u>white Blue clay</u> <u>Blue clay</u> <u>med Sand</u>	<u>20</u> <u>110</u> <u>100</u> <u>220</u>	<u>40</u> <u>100</u> <u>220</u> <u>278</u>
WELL PURPOSE: (Home, Irrigation, municipal, Industrial)			
WELL COMPLETION DATA:			
(1) diameter (inches) <u>2"</u>			
(2) total depth (feet) <u>278'</u>			
(3) static water level (feet) <u>60'</u> <u>below</u> above top of ground.			
(4) casing <u>Pvc</u> , <u>278'</u> (material), (depth)			
_____ (size) if telescope see back.			
(5) screen <u>10'</u> , <u>278'</u> (length), (depth to top)			
_____ (size), _____ (material)			
(6) pump <u>1</u> , <u>6</u> (HP), (yield gpm)			
_____ (type power)			
(7) electric log _____ (yes or no)			
_____ (organization running log)			
(8) how well bottom plugged _____ <u>no</u>			

RECEIVED


NOV 04 1987

Department of Natural Resources
Bureau of Land & Water Resources

DRILLERS REMARKS:

If well telescopes please sketch and show depths.

GROUND LEVEL

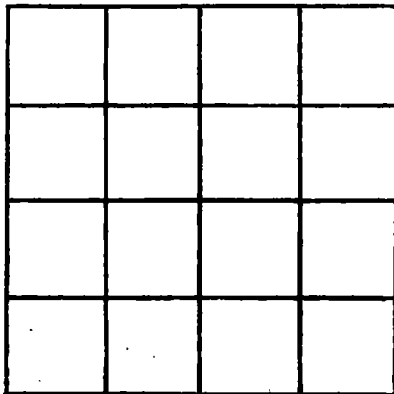

1 Block EAST
ST MARTIN COMMUNITY
SECTION CENTER

Please indicate well location X.

ADDITIONAL INFORMATION

If more than one screen,
show locations of each on sketch.