

MISSISSIPPI DEPARTMENT OF NATURAL RESOURCES
Bureau of Land and Water Resources

P.O. Box 10631
Jackson, Mississippi 39209
WATER WELL DRILLERS LOG

COUNTY WELL LOCATED JACKSON	
WELL NUMBER N 2321	LOGGED
DATE WELL COMPLETED 20 DEC 89	

PERMIT NUMBER 0-485
NAME OF DRILLING FIRM CRATER

NAME & MAILING ADDRESS OF LANDOWNER LOUIS BOND			
123 MORRIS NOBLE Rd			
OCEAN SPRINGS, Ms 39564			
WELL LOCATION:	SEC	TOWNSHIP	RANGE
	1	7	8
		(S)	(W)
DISTANCE	DIRECTION	NEAREST TOWN	
10 Miles	NORTH	OCEAN SPRINGS	
OTHER LANDMARK 3 Miles NORTH OF I-10			
WELL PURPOSE: Home, Irrigation, Municipal, Industrial, Fish Pond, etc. HOME			

PUMP DATA		
PUMP TYPE (Circle One): Submersible, Turbine, (Jet) Flowing Well, Other (Describe) _____		
POWER TYPE (Circle One): (Electric) Tractor, Diesel, Gasoline, Butane, Other (Describe) _____		
Pump Capacity (GPM) 15	No. of Stages 1	Setting Depth 60 FT.
PUMP TEST Well yielded 14 GPM with a drawdown of 20 ft. after 3 hours of pumping		

WELL DATA		
Well Depth 98'	Casing Diameter (In.) 2"	Casing Length (Ft.) 88'
Type of Casing PVE	Hole Depth 100'	Depth to Static Water Level 26'
TYPE OF COMPLETION: (Circle One or More): Gravel Packed, Underreamed, Telescoped, (Natural Development) Open Hole, Other (Describe) _____		
Top of Lap Pipe or Reduction in Casing N/A FEET		
IF TELESCOPED OR MORE THAN ONE SCREEN: USE BACK PAGE		

LOG DATA	
TYPE OF LOG RUN (Circle One): Electric, Gamma Ray, Density, Sonic, (No Log Run) , Neutron, Other (Describe) _____	
Name of Organization Running Log N/A	

SCREEN DATA		
Diameter - Inches 2"	Length - Feet 10'	Slot Size - Inches # 8
Screen Type WRAPPED PVE	Depth to Bottom - Feet 88'-98'	


GEOLOGIC DATA (Office Use Only)			
Surface Elev.	Geologic Unit	Unit Thickness	Depth to Top
Subs. SWL	Date	Analysis	Aquifer Test
Driller's Remarks None			

DESCRIPTION OF FORMATIONS ENCOUNTERED	FROM	TO	FORMATIONS (Continued) FROM	TO
TOP SOIL	0	2	RECEIVED FEB 26 1990 Department of Natural Resources Bureau of Land & Water Resources	
YELLOW SANDY CLAY	3	18		
WHITE SAND - COURSE	19	32		
GRAY SANDY CLAY	33	60		
BLUE MUD - w- FRAG. SHELLS	61	66		
FINE SALT + PEPPER SAND	67	72		
BLUE MUD - w- SHELL FRAG.	73	76		
COURSE SALT + PEPPER SAND	77	99		
BLUE MUD	100	→		

IF MORE SPACE IS NEEDED, USE BACK

If well telescopes please sketch and show depths.

GROUND LEVEL

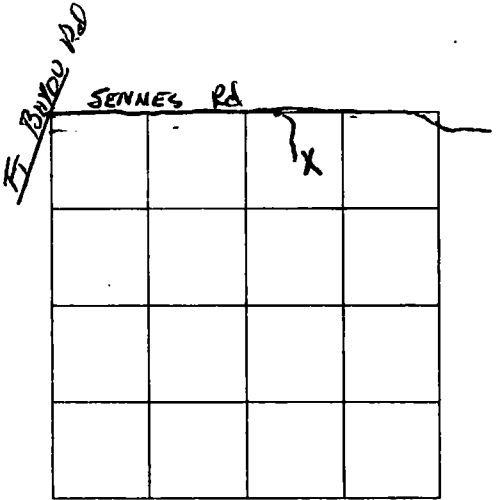

SECTION 1

Please indicate well location X.

ADDITIONAL INFORMATION

If more than one screen,
show location of each on sketch.