

(add) see pump
MISSISSIPPI DEPARTMENT OF NATURAL RESOURCES
 Bureau of Land and Water Resources

P.O. Box 10631

Jackson, Mississippi 39209

WATER WELL DRILLERS LOG

COUNTY WELL LOCATED Jackson	
WELL NUMBER N 2330	CODED
DATE WELL COMPLETED 9-14-87	

PERMIT NUMBER
NAME OF DRILLING FIRM Coast Water Well Serv. Inc

NAME & MAILING ADDRESS OF LANDOWNER Dr. Drake			
95 Lebrance Rd			
Ocean Springs MS			
WELL LOCATION:	SEC 32	TOWNSHIP 7	RANGE 8
DISTANCE — Miles		DIRECTION —	NEAREST TOWN Ocean Springs
OTHER LANDMARK			
WELL PURPOSE: Home, Irrigation, Municipal, Industrial, Fish Pond, etc. Lawncare			

PUMP DATA		
PUMP TYPE (Circle One): Submersible, Turbine, Jet , Flowing Well, Other (Describe) _____		
POWER TYPE (Circle One): Electric , Tractor, Diesel, Gasoline, Butane, Other (Describe) _____		
Pump Capacity (GPM) 12.	No. of Stages 2	Setting Depth — FT.
PUMP TEST —		
Well yielded _____ GPM with a drawdown of _____ ft. after _____ hours of pumping		

WELL DATA		
Well Depth 70'	Casing Diameter (In.) 2"	Casing Length (Ft.) 60
Type of Casing PVC	Hole Depth 70'	Depth to Static Water Level Age
TYPE OF COMPLETION: (Circle One or More) Natural Development , Gravel Packed, Underreamed, Telescoped, Open Hole, Other		
Top of Lap Pipe or Reduction in Casing FEET IF TELESKOPED OR MORE THAN ONE SCREEN: USE BACK PAGE		

LOG DATA	
TYPE OF LOG RUN (Circle One): Electric, Gamma Ray, Density, Sonic, No Log Run , Neutron, Other (Describe) _____	
Name of Organization Running Log	

SCREEN DATA		
Diameter - Inches 2"	Length - Feet 10'	Slot Size - Inches .008
Screen Type PVC	Depth to Bottom - Feet 70'	

GEOLOGIC DATA (Office Use Only)			
Surface Elev.	Geologic Unit	Unit Thickness	Depth to Top
Subs. SWL	Date	Analysis	Aquifer Test


Driller's Remarks

DESCRIPTION OF FORMATIONS ENCOUNTERED	FROM	TO
Top Soil	0	2
White Coarse Sand	2	15
Blue Clay w/ streaks of sand	15	40
Gray Coarsened Sand	40	70

FORMATIONS (Continued)	FROM	TO
RECEIVED		
MAY 24 1988		
Department of Natural Resources Bureau of Land & Water Resources		
IF MORE SPACE IS NEEDED, USE BACK		

If well telescopes please sketch and show depths.

GROUND LEVEL

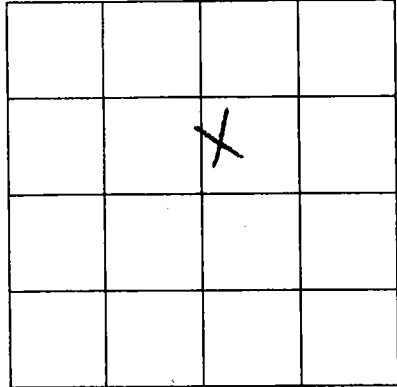

SECTION 32

Please indicate well location X.

ADDITIONAL INFORMATION

If more than one screen,
show location of each on sketch.