

~~add-loc-plate~~
MISSISSIPPI DEPARTMENT OF NATURAL RESOURCES
 Bureau of Land and Water Resources

P.O. Box 10631
 Jackson, Mississippi 39209
WATER WELL DRILLERS LOG

COUNTY WELL LOCATED Jackson	
WELL NUMBER N 9335	CODED
DATE WELL COMPLETED 11-7-87	

PERMIT NUMBER
NAME OF DRILLING FIRM Coast Water Well Service Inc

NAME & MAILING ADDRESS OF LANDOWNER Alfred Speed		
PO Box 235		
Ocean Springs MO		
WELL LOCATION: SEC	TOWNSHIP	RANGE
23	7	8
DISTANCE	DIRECTION	NEAREST TOWN
3 Miles	ENE	O Springs
OTHER LANDMARK		
WELL PURPOSE: Home, Irrigation, Municipal, Industrial, Fish Pond, etc. home		

PUMP DATA MSE		
PUMP TYPE (Circle One): Submersible, Turbine, Jet Flowing Well, Other (Describe)		
POWER TYPE (Circle One): Electric Tractor, Diesel, Gasoline, Butane, Other (Describe)		
Pump Capa (GPM) 17	No. of Stages 2	Setting Depth — FT.
PUMP TEST		
Well yielded — GPM with a drawdown of — ft. after — hours of pumping		

WELL DATA		
Well Depth 490'	Casing Diameter (In.) 2"	Casing Length (Ft.) 480'
Type of Casing PVC	Hole Depth 495'	Depth to Static Water Level 62'
TYPE OF COMPLETION: (Circle One or More): Natural Development , Gravel Packed, Underreamed, Telescoped, Open Hole, Other (Describe)		
Top of Lap Pipe or Reduction in Casing		
FEET	IF TELESCOPED OR MORE THAN ONE SCREEN: USE BACK PAGE	

LOG DATA	
TYPE OF LOG RUN (Circle One): Electric, Gamma Ray, Density, Sonic, Neutron, Other (Describe) No Log Run	
Name of Organization Running Log	

SCREEN DATA		
Diameter - Inches 2'	Length - Feet 10'	Slot Size - Inches .008
Screen Type PVC	Depth to Bottom - Feet 490'	

GEOLOGIC DATA (Office Use Only)			
Surface Elev.	Geologic Unit	Unit Thickness	Depth to Top
Subs. SWL	Date	Analysis	Aquifer Test
Driller's Remarks			

RECEIVED

MAY 24 1988


Department of Natural Resources
 Bureau of Land & Water Resources

DESCRIPTION OF FORMATIONS ENCOUNTERED	FROM	TO	FORMATION (N.S. Considered)	FROM	TO
Top Soil	0	2			
Blue Clay	2	67			
Med Gray Sand	67	85			
Blue Clay	85	107			
Med Gray Sand	107	128			
Fine Gray Sand	128	216			
Blue Clay	216	442			
Med Gray Sand	442	490			
Blue Clay	490	495			

IF MORE SPACE IS NEEDED, USE BACK

If well telescopes please sketch and show depths.

GROUND LEVEL

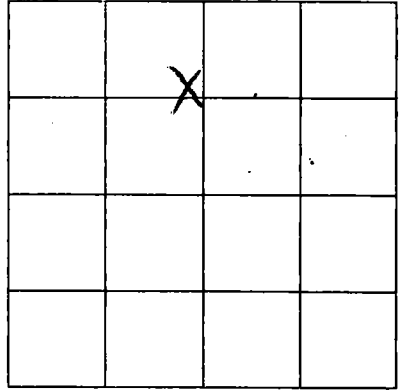

SECTION a3

Please indicate well location X.

ADDITIONAL INFORMATION

If more than one screen,
show location of each on sketch.