

~~Location~~
MISSISSIPPI DEPARTMENT OF NATURAL RESOURCES
 Bureau of Land and Water Resources

P.O. Box 10631

Jackson, Mississippi 39209

WATER WELL DRILLERS LOG

COUNTY WELL LOCATED
Jackson

WELL NUMBER CODED
N23316

DATE WELL COMPLETED
12-9-87

PERMIT NUMBER

NAME OF DRILLING FIRM
Coastwater well Service

NAME & MAILING ADDRESS OF LANDOWNER
Rodney Budinich

33 Davis Bayou Rd

Ocean Springs MS

WELL LOCATION: SEC **34** TOWNSHIP **7^N 8^W** RANGE **8^W**

DISTANCE **4** Miles DIRECTION **SW.** NEAREST TOWN **Ocean Springs**

OTHER LANDMARK

WELL PURPOSE: Home, Irrigation, Municipal, Industrial, Fish Pond, etc.
home

PUMP DATA

PUMP TYPE (Circle One):
 Submersible, Turbine, **Jet** Flowing Well,
 Other (Describe) _____

POWER TYPE (Circle One):
Electric, Tractor, Diesel, Gasoline, Butane,
 Other (Describe) _____

Pump Capacity (GPM) **7** No. of Stages **2** Setting Depth **—** FT.

PUMP TEST

Well yielded **—** GPM with
 a drawdown of **—** ft.
 after **—** hours of pumping

WELL DATA

Well Depth **420' 15"** Casing Diameter (In.) **2"** Casing Length (Ft.) **405'**

Type of Casing **PVC** Hole Depth **420'** Depth to Static Water Level **55'**

TYPE OF COMPLETION: (Circle One or More):
 Gravel Packed, Underreamed, Telescoped,
Natural Development, Open Hole, Other

Top of Lap Pipe or Reduction in Casing

FEET IF TELESCOPED OR MORE THAN ONE SCREEN: USE BACK PAGE

LOG DATA

TYPE OF LOG RUN (Circle One):
 Electric, Gamma Ray, Density, Sonic, **No Log Run**,
 Other (Describe) _____

Name of Organization Running Log

SCREEN DATA

Diameter - Inches **2"** Length - Feet **10'** Slot Size - Inches **.008**

Screen Type **PVC** Depth to Bottom - Feet **415'**

GEOLOGIC DATA (Office Use Only)

Surface Elev.	Geologic Unit	Unit Thickness	Depth to Top
Subs. SWL	Date	Analysis	Aquifer Test

Driller's Remarks

RECEIVED

DESCRIPTION OF FORMATIONS ENCOUNTERED	FROM	TO	FORMATION (Continued)	FROM	TO
Top soil	0	2			
White coarse sand	2	13			
Blue clay	13	41			
White coarse sand	41	55			
Blue clay	55	94			
med Gray sand	94	148			
Blue clay	148	390			
Gray coarse sand	390	418			
Blue clay	418	420			


MAY 24 1988

Department of Natural Resources
Bureau of Land & Water Resources

IF MORE SPACE IS NEEDED, USE BACK

If well telescopes please sketch and show depths.

GROUND LEVEL

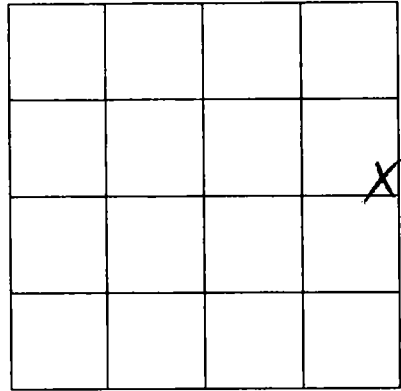

SECTION 34

Please indicate well location X.

ADDITIONAL INFORMATION

If more than one screen,
show location of each on sketch.