

loc. 1
MISSISSIPPI DEPARTMENT OF NATURAL RESOURCES
 Bureau of Land and Water Resources

P.O. Box 10631

Jackson, Mississippi 39209

WATER WELL DRILLERS LOG

COUNTY WELL LOCATED
Jackson

WELL NUMBER CODED
N2331

DATE WELL COMPLETED
5-2-88

PERMIT NUMBER

NAME OF DRILLING FIRM
Coastwater Well Service

NAME & MAILING ADDRESS OF LANDOWNER
Ruth Macy
10821 Eagle Nest Rd.
Ocean Springs Mo.

WELL LOCATION: SEC 33 TOWNSHIP 7^N RANGE 8^E
S W

DISTANCE 1/2 MILES DIRECTION SE NEAREST TOWN OCEAN SPRINGS

OTHER LANDMARK

WELL PURPOSE: Home, Irrigation, Municipal, Industrial, Fish Pond, etc.
Home

PUMP DATA

PUMP TYPE (Circle One):
 Submersible, Turbine, Jet, Flowing Well.
 Other (Describe) _____

POWER TYPE (Circle One):
 Electric, Tractor, Diesel, Gasoline, Butane,
 Other (Describe) _____

Pump Capacity (GPM) _____ No. of Stages _____ Setting Depth _____ FT.

PUMP TEST

Well yielded _____ GPM with
 a drawdown of _____ ft.
 after _____ hours of pumping

WELL DATA

Well Depth 540 Casing Diameter (In.) 2" Casing Length (Ft.) 520

Type of Casing PVC Hole Depth 545 Depth to Static Water Level 55'

TYPE OF COMPLETION: (Circle One or More):
 Gravel Packed, Underreamed, Telescoped,
 Natural Development, Open Hole, Other

Top of Lap Pipe or Reduction in Casing

FEET IF TELESCOPED OR MORE THAN ONE SCREEN: USE BACK PAGE

LOG DATA

TYPE OF LOG RUN (Circle One): No Log Run
 Electric, Gamma Ray, Density, Sonic, Neutron,
 Other (Describe) _____

Name of Organization Running Log

SCREEN DATA

Diameter - Inches 2" Length - Feet 20' Slot Size - Inches .008

Screen Type PVC Depth to Bottom - Feet 540'

GEOLOGIC DATA (Office Use Only)

Surface Elev.	Geologic Unit	Unit Thickness	Depth to Top
Subs. SWL	Date	Analysis	Aquifer Test

Driller's Remarks

DESCRIPTION OF FORMATIONS ENCOUNTERED	FROM	TO	FORMATIONS (Circled)	TO
Top Soil	0	2	Med Gray Sand	540
Blue Clay	2	45	Blue Clay	540
White Coarse Sand + Gravel	45	63		
Blue Clay	63	128		
Fine Gray Sand	128	167		
Blue Clay	167	280		
Med Gray Sand	280	300		
Blue Clay	300	415		
Med Gray Sand	415	450		
Blue Clay	450	480		


MAY 21 1988

Department of Natural Resources
Bureau of Land & Water Resources

IF MORE SPACE IS NEEDED, USE BACK

If well telescopes please
sketch and show depths.

GROUND LEVEL

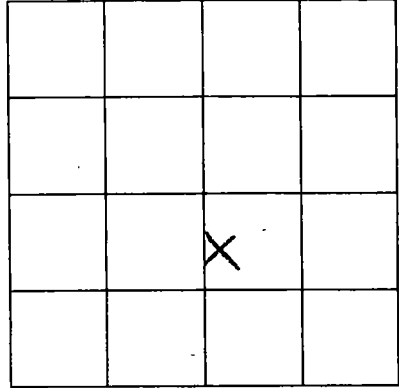

SECTION 33

Please indicate well location X.

ADDITIONAL INFORMATION

If more than one screen,
show location of each on sketch.