

**MISSISSIPPI DEPARTMENT OF NATURAL RESOURCES**  
Bureau of Land and Water Resources

P.O. Box 10631

Jackson, Mississippi 39209

**WATER WELL DRILLERS LOG**

COUNTY WELL LOCATED  
*Jac prou*

WELL NUMBER: *9331N*      CODED

DATE WELL COMPLETED: *10-3-88*

PERMIT NUMBER

NAME OF DRILLING FIRM  
*Coast Water Well*

NAME & MAILING ADDRESS OF LANDOWNER  
*Susan Wood road*

*14308 Cullen St.*

*Biloxie, Ms. 39532*

WELL LOCATION:      SEC      TOWNSHIP      RANGE

*12*      *7*      *N*      *9*      *W*

DISTANCE      DIRECTION      NEAREST TOWN

*3*      *N*      *Coast*

Miles      of      *Spring*

OTHER LANDMARK

WELL PURPOSE: Home, Irrigation, Municipal, Industrial, Fish Pond, etc.  
*home*

**PUMP DATA**

PUMP TYPE (Circle One):  
Submersible, Turbine, Jet, Flowing Well,  
Other (Describe) \_\_\_\_\_

POWER TYPE (Circle One):  
Electric, Tractor, Diesel, Gasoline, Butane,  
Other (Describe) \_\_\_\_\_

Pump Capacity (GPM)      Number of Stages      Setting Depth

\_\_\_\_\_      \_\_\_\_\_      \_\_\_\_\_ FT.

PUMP TEST *None*

Well yielded \_\_\_\_\_ GPM with  
a drawdown of \_\_\_\_\_ ft.  
after \_\_\_\_\_ hours of pumping

**WELL DATA**

Well Depth <i>60'</i>	Casing Diameter (In.) <i>2"</i>	Casing Length (Ft.) <i>50'</i>
Type of Casing <i>PVC</i>	Hole Depth <i>60'</i>	Depth to Static Water Level <i>19'</i>

TYPE OF COMPLETION: (Circle One or More):  
 Gravel Packed,       Underreamed,       Telescoped,  
 Natural Development,       Open Hole,       Other

Top of Lap Pipe or Reduction in Casing

FEET      IF TELESCOPED OR MORE THAN ONE SCREEN: USE BACK PAGE

**LOG DATA**

TYPE OF LOG RUN (Circle One):  
Electric, Gamma Ray, Density, Sonic,  No Log Run, Neutron,  
Other (Describe) \_\_\_\_\_

Name of Organization Running Log

**SCREEN DATA**

Diameter - Inches <i>2"</i>	Length - Feet <i>10'</i>	Slot Size - Inches <i>1008</i>
Screen Type <i>PVC</i>	Depth to Bottom - Feet <i>60'</i>	

**GEOLOGIC DATA (Office Use Only)**

Surface Elev.	Geologic Unit	Unit Thickness	Depth to Top
Subs. SWL	Date	Analysis	Aquifer Test

Driller's Remarks

DESCRIPTION OF FORMATIONS ENCOUNTERED	FROM	TO
<i>Top Soil</i>	<i>0</i>	<i>2</i>
<i>Brown Clay</i>	<i>2</i>	<i>49</i>
<i>Brown Coarse Sand</i>	<i>49</i>	<i>50</i>

**DEPARTMENT OF NATURAL RESOURCES**

**BUREAU OF LAND & WATER RESOURCES**


NOV 15 1988

Department of Natural Resources  
Bureau of Land & Water Resources

IF MORE SPACE IS NEEDED, USE BACK

If well telescopes please sketch and show depths.

GROUND LEVEL

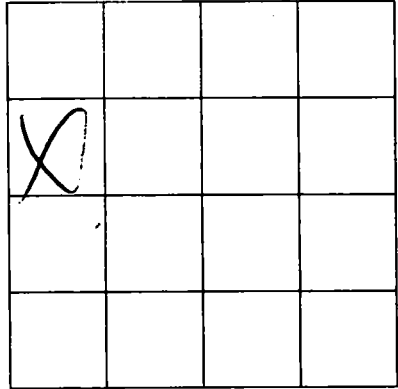

SECTION 12

Please indicate well location X.

ADDITIONAL INFORMATION

Lined area for additional information.

If more than one screen, show location of each on sketch.