

**MISSISSIPPI DEPARTMENT OF NATURAL RESOURCES**  
Bureau of Land and Water Resources

P.O. Box 10631  
Jackson, Mississippi 39209  
**WATER WELL DRILLERS LOG**

COUNTY WELL LOCATED <b>Jackson</b>	
WELL NUMBER <b>9341N</b>	CODED
DATE WELL COMPLETED <b>9-15-88</b>	

PERMIT NUMBER
NAME OF DRILLING FIRM <b>Coast Water Well Service</b>

NAME & MAILING ADDRESS OF LANDOWNER <b>Joe Soche</b>			
<b>PO Box 818</b>			
<b>Ocean Springs MD</b>			
WELL LOCATION:	SEC	TOWNSHIP	RANGE
<b>4</b>	<b>23</b>	<b>7<sup>N</sup></b>	<b>8<sup>E</sup></b>
DISTANCE	DIRECTION	NEAREST TOWN	
<b>3</b> Miles	<b>NE</b>	<b>Ocean Springs</b>	
OTHER LANDMARK			
WELL PURPOSE: Home, Irrigation, Municipal, Industrial, Fish Pond, etc. <b>Home</b>			

<b>PUMP DATA</b>	
PUMP TYPE (Circle One): Submersible, Turbine, Jet, Flowing Well, Other (Describe)	
POWER TYPE (Circle One): Electric, Tractor, Diesel, Gasoline, Butane, Other (Describe)	
Pump Capacity (GPM)	No. of Stages / Setting Depth <b>None</b> FT.
PUMP TEST	
Well yielded _____ GPM with a drawdown of _____ ft. after _____ hours of pumping	

<b>WELL DATA</b>		
Well Depth <b>788</b> <b>402'</b>	Casing Diameter (In.) <b>2"</b>	Casing Length (Ft.) <b>388'</b>
Type of Casing <b>PVC</b>	Hole Depth <b>402'</b>	Depth to Static Water Level <b>65'</b>
TYPE OF COMPLETION: (Circle One or More): <b>Gravel Packed</b> , Underreamed, Telescoped, <b>Natural Development</b> , Open Hole, Other		
Top of Lap Pipe or Reduction in Casing FEET IF TELESCOPED OR MORE THAN ONE SCREEN: USE BACK PAGE		

<b>LOG DATA</b>	
TYPE OF LOG RUN (Circle One): Electric, Gamma Ray, Density, Sonic, <b>No Log Run</b> , Neutron, Other (Describe)	
Name of Organization Running Log	

<b>SCREEN DATA</b>		
Diameter - Inches <b>2"</b>	Length - Feet <b>10'</b>	Slot Size - Inches <b>.008</b>
Screen Type <b>PVC</b>	Depth to Bottom - Feet <b>398</b>	


<b>GEOLOGIC DATA (Office Use Only)</b>			
Surface Elev.	Geologic Unit	Unit Thickness	Depth to Top
Subs. SWL	Date	Analysis	Aquifer Test
Driller's Remarks <b>NOV 15 1988</b>			
Department of Natural Resources Bureau of Land & Water Resources			

DESCRIPTION OF FORMATIONS ENCOUNTERED	FROM	TO	FORMATIONS (Continued)	FROM	TO
<b>Top Soil</b>	<b>0</b>	<b>2</b>	<b>Blue Clay</b>	<b>130</b>	<b>154</b>
<b>Red Clay</b>	<b>2</b>	<b>15</b>	<b>Gray Fine Sand</b>	<b>154</b>	<b>168</b>
<b>Blue Clay</b>	<b>15</b>	<b>20</b>	<b>Blue Clay</b>	<b>168</b>	<b>172</b>
<b>Gray Fine Sand</b>	<b>20</b>	<b>28</b>	<b>Gray Fine Sand</b>	<b>172</b>	<b>182</b>
<b>Blue Clay</b>	<b>28</b>	<b>74</b>	<b>Blue Clay</b>	<b>182</b>	<b>213</b>
<b>Gray Fine Sand w/ streaks of clay</b>	<b>74</b>	<b>86</b>	<b>Blue Clay w/ streaks of sand</b>	<b>213</b>	<b>225</b>
<b>Blue Clay</b>	<b>86</b>	<b>100</b>	<b>Blue Clay</b>	<b>225</b>	<b>270</b>
<b>Blue Clay w/ streaks of sand</b>	<b>100</b>	<b>110</b>	<b>Gray Fine Sand w/ streaks of clay</b>	<b>270</b>	<b>310</b>
<b>Gray Fine Sand</b>	<b>110</b>	<b>130</b>	<b>Blue Clay</b>	<b>310</b>	<b>364</b>

IF MORE SPACE IS NEEDED USE BACK

If well telescopes please sketch and show depths.

GROUND LEVEL

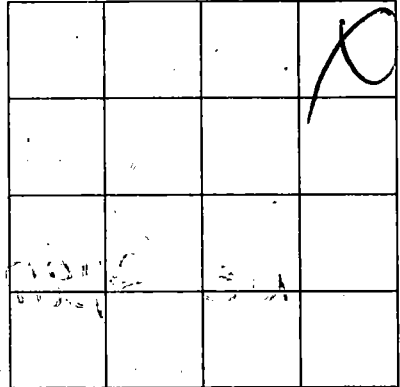

SECTION 23

Please indicate well location X.

ADDITIONAL INFORMATION

3174-3207 (Group) - 1 screen  
3177-3918 (Group) - 1 screen  
3175-403 (Block) - 1 screen

If more than one screen,  
show location of each on sketch.