

**MISSISSIPPI DEPARTMENT OF NATURAL RESOURCES**  
Bureau of Land and Water Resources

P.O. Box 10631  
Jackson, Mississippi 39209  
**WATER WELL DRILLERS LOG**

COUNTY WELL LOCATED <i>Jackson</i>	
WELL NUMBER <i>2342N</i>	CODED
DATE WELL COMPLETED <i>9-5-88</i>	

PERMIT NUMBER
NAME OF DRILLING FIRM <i>Coast Water Well</i>

NAME & MAILING ADDRESS OF LANDOWNER <i>Phil King</i>		
<i>2719 English Dr.</i>		
<i>Ocean Springs, Mo</i>		
WELL LOCATION: SEC	TOWNSHIP	RANGE
<i>34</i>	<i>7<sup>N</sup> 8<sup>S</sup></i>	<i>8<sup>E</sup> 8<sup>W</sup></i>
DISTANCE <i>4</i> Miles	DIRECTION <i>SE</i>	NEAREST TOWN <i>Spring</i>
OTHER LANDMARK		
WELL PURPOSE: Home, Irrigation, Municipal, Industrial, Fish Pond, etc. <i>home</i>		

PUMP DATA		
PUMP TYPE (Circle One): Submersible, Turbine, <b>Jet</b> Flowing Well, Other (Describe) _____		
POWER TYPE (Circle One): <b>Electric</b> Tractor, Diesel, Gasoline, Butane, Other (Describe) _____		
Pump Capacity (GPM) <i>14</i>	No. of Stages <i>3</i>	Setting Depth <i>—</i> FT.
PUMP TEST		
Well yielded _____ GPM with a drawdown of _____ ft. after _____ hours of pumping		

WELL DATA		
Well Depth <i>430'</i>	Casing Diameter (In.) <i>2"</i>	Casing Length (Ft.) <i>410'</i>
Type of Casing <i>PVC</i>	Hole Depth <i>435'</i>	Depth to Static Water Level <i>58'</i>
TYPE OF COMPLETION: (Circle One or More): <b>Natural Development</b> , Underreamed, Telescoped, Open Hole, Other		
Top of Lap Pipe or Reduction in Casing		
FEET	IF TELESCOPED OR MORE THAN ONE SCREEN: USE BACK PAGE	

LOG DATA	
TYPE OF LOG RUN (Circle One): Electric, Gamma Ray, Density, Sonic, Neutron, Other (Describe) _____	
Name of Organization Running Log	

GEOLOGIC DATA (Office Use Only)			
Surface Elev.	Geologic Unit	Unit Thickness	Depth to Top
Subs. SWC	Date	Analysis	Aquifer Test

SCREEN DATA		
Diameter - Inches <i>2"</i>	Length - Feet <i>20'</i>	Slot Size - Inches <i>.008</i>
Screen Type <i>PVC</i>	Depth to Bottom - Feet <i>430'</i>	


Driller's Remarks <i>NOV 15 1988</i>
<b>Department of Natural Resources</b> <b>Bureau of Land &amp; Water Resources</b>

DESCRIPTION OF FORMATIONS ENCOUNTERED	FROM	TO	FORMATIONS (Continued)	FROM	TO
<i>Sandy silt</i>	<i>0</i>	<i>10</i>	<i>Gray Coarse Sand</i>	<i>402</i>	<i>433</i>
<i>Blue Clay</i>	<i>10</i>	<i>50</i>	<i>Blue Clay</i>	<i>433</i>	<i>435</i>
<i>White Coarse Sand</i>	<i>50</i>	<i>62</i>			
<i>Blue Clay</i>	<i>62</i>	<i>100</i>			
<i>Gray Coarse Sand (Clay)</i>	<i>100</i>	<i>120</i>			
<i>Coarse Sand</i>	<i>120</i>	<i>155</i>			
<i>Blue Clay</i>	<i>155</i>	<i>180</i>			
<i>Blue Clay with silt of sand</i>	<i>180</i>	<i>195</i>			
<i>Blue Clay</i>	<i>195</i>	<i>385</i>			
<i>Gray Coarse Sand</i>	<i>385</i>	<i>390</i>			
<i>Blue Clay</i>	<i>390</i>	<i>402</i>			

IF MORE SPACE IS NEEDED, USE BACK

If well telescopes please  
sketch and show depths.

GROUND LEVEL

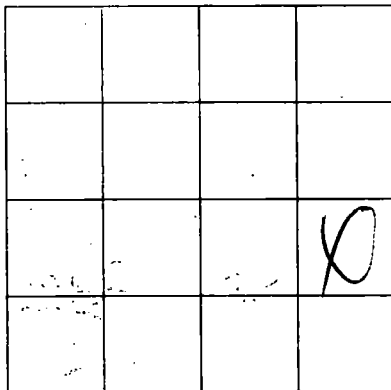

SECTION 34

Please indicate well location X.

ADDITIONAL INFORMATION

If more than one screen,  
show location of each on sketch.