

# MISSISSIPPI DEPARTMENT OF NATURAL RESOURCES

Bureau of Land and Water Resources

P.O. Box 10631

Jackson, Mississippi 39209

## WATER WELL DRILLERS LOG

COUNTY WELL LOCATED <i>Jackson</i>	
WELL NUMBER <i>N 2369</i>	CODED
DATE WELL COMPLETED <i>5-2-90</i>	

PERMIT NUMBER
NAME OF DRILLING FIRM <i>Coast Water Well Drilling</i>

NAME & MAILING ADDRESS OF LANDOWNER <i>Holman Hunt</i>			
NAME <i>Bilou, Ms.</i>			
WELL LOCATION	SEC	TOWNSHIP	RANGE
	<i>15</i>	<i>7</i>	<i>9</i>
DISTANCE	DIRECTION	NEAREST TOWN	
<i>1 1/2</i> Miles		of <i>St. Martin</i>	
OTHER LANDMARK			
WELL PURPOSE <input checked="" type="checkbox"/> Home Irrigation, <input type="checkbox"/> Municipal, <input type="checkbox"/> Industrial, <input type="checkbox"/> Fish Pond, etc.			

<b>PUMP DATA</b>		
PUMP TYPE (Circle One): Submersible, Turbine, <input checked="" type="radio"/> Jet, Flowing Well, Other (Describe) _____		
POWER TYPE (Circle One): <input checked="" type="radio"/> Electric, Tractor, Diesel, Gasoline, Butane, Other (Describe) _____ H/P _____		
Pump Capacity (GPM) <i>8</i>	No. of Stages <i>2</i>	Setting Depth   <b>FT.</b>
PUMP TEST		
Well yielded _____ GPM with a drawdown of _____ ft. after _____ hours of pumping		

<b>WELL DATA</b>		
Well Depth <i>511'</i>	Casing Diameter (In.) <i>2'</i>	Casing Length (Ft.) <i>496</i>
Type of Casing <i>PVC</i>	Hole Depth <i>516'</i>	Depth to Static Water Level <i>69'</i>
TYPE OF COMPLETION: (Circle One or More): <input checked="" type="checkbox"/> Gravel Packed, <input type="checkbox"/> Underreamed, <input type="checkbox"/> Telescoped, <input checked="" type="checkbox"/> Natural Development, <input type="checkbox"/> Open Hole, <input type="checkbox"/> Other		
Top of Lap Pipe or Reduction in Casing		
FEET <input type="checkbox"/> IF TELESCOPED OR MORE THAN ONE SCREEN: USE BACK PAGE		

<b>LOG DATA</b>	
TYPE OF LOG RUN (Circle One): Electric, Gamma Ray, Density, Sonic, Neutron, Other (Describe) _____	
Name of Organization Running Log	

<b>SCREEN DATA</b>		
Diameter - Inches <i>2"</i>	Length - Feet <i>15'</i>	Slot Size - Inches <i>.008</i>
Screen Type <i>PVC</i>	Depth to Bottom - Feet <i>511'</i>	


<b>GEOLOGIC DATA (Office Use Only)</b>			
Surface Elev.	Geologic Unit	Unit Thickness	Depth to Top
Subs. SWL	Date	Analysis	Aquifer Test
Driller's Remarks			

DESCRIPTION OF FORMATIONS ENCOUNTERED	FROM	TO	FORMATIONS (Continued)	FROM	TO
<i>Stratified Clay</i>	<i>0</i>	<i>14</i>	<b>RECEIVED</b>  <i>OCT 12 1990</i>  Department of Natural Resources Bureau of Land & Water Resources		
<i>Gray Clay</i>	<i>14</i>	<i>20</i>			
<i>Broken coarse sand</i>	<i>20</i>	<i>38</i>			
<i>Blue Clay</i>	<i>38</i>	<i>110</i>			
<i>Gray fine sand</i>	<i>110</i>	<i>155</i>			
<i>Blue Clay</i>	<i>155</i>	<i>450</i>			
<i>Blue Clay with shells</i>	<i>450</i>	<i>480</i>			
<i>Gray Med. sand</i>	<i>480</i>	<i>494</i>			
<i>Gray Coarse sand</i>	<i>494</i>	<i>511</i>			
<i>Blue Clay</i>	<i>511</i>	<i>516</i>			

IF MORE SPACE IS NEEDED, USE BACK

If well telescopes please sketch and show depths.

GROUND LEVEL

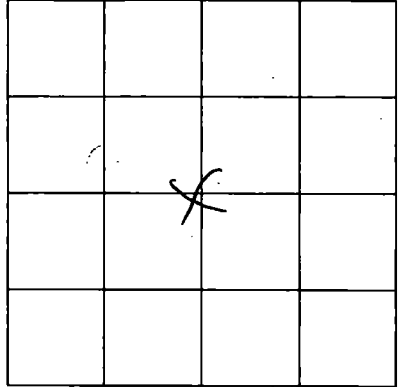

SECTION 15

Please indicate well location X.

ADDITIONAL INFORMATION

If more than one screen,  
show location of each on sketch.