

MISSISSIPPI DEPARTMENT OF NATURAL RESOURCES

Bureau of Land and Water Resources

P.O. Box 10631
Jackson, Mississippi 39209
WATER WELL DRILLERS LOG

COUNTY WELL LOCATED	<i>Jackson</i>
WELL NUMBER	<i>N2371</i>
DATE WELL COMPLETED	<i>6-27-90</i>

PERMIT NUMBER
NAME OF DRILLING FIRM
<i>Coast Water Well, Ser. Inc.</i>

NAME & MAILING ADDRESS OF LANDOWNER		
<i>Howard Dugger</i>		
<i>Sumlow Dr.</i>		
<i>Dan Spry Jr</i>		
WELL LOCATION:	SEC	TOWNSHIP RANGE
	<i>18</i>	<i>7 (S) 8 (W)</i>
DISTANCE	DIRECTION	NEAREST TOWN
<i>3/4</i> Miles	<i>NW</i>	<i>Ocean Springs</i>
OTHER LANDMARK		
WELL PURPOSE: Home, Irrigation, Municipal, Industrial, Fish Pond, etc.		
<i>Lawson well</i>		

PUMP DATA		
PUMP TYPE (Circle One):		
Submersible, Turbine, <input checked="" type="radio"/> Flowing Well		Other (Describe)
POWER TYPE (Circle One):		
<input checked="" type="radio"/> Electric , Tractor, Diesel, Gasoline, Butane,		Other (Describe)
H/P <i>1/2</i>		
Pump Capacity (GPM)	No. of Stages	Setting Depth
<i>9</i>	<i>1</i>	FT.
PUMP TEST		
Well yielded _____ GPM with		
a drawdown of _____ ft.		
after _____ hours of pumping		


WELL DATA		
Well Depth	Casing Diameter (In.)	Casing Length (Ft.)
<i>50'</i>	<i>2"</i>	<i>45'</i>
Type of Casing	Hole Depth	Depth to Static Water Level
<i>PVC</i>	<i>50'</i>	<i>22'</i>
TYPE OF COMPLETION: (Circle One or More):		
<input checked="" type="radio"/> Gravel Packed , <input type="radio"/> Underreamed, <input type="radio"/> Telescoped,		
<input checked="" type="radio"/> Natural Development , <input type="radio"/> Open Hole, <input type="radio"/> Other		
Top of Lap Pipe or Reduction in Casing		
FEET		IF TELESCOPED OR MORE THAN ONE SCREEN: USE BACK PAGE

LOG DATA		
TYPE OF LOG RUN (Circle One):		
Electric, Gamma Ray, Density, Sonic, Neutron,		<input checked="" type="radio"/> No Log Run
Other (Describe)		
Name of Organization Running Log		

SCREEN DATA		
Diameter - Inches	Length - Feet	Slot Size - Inches
<i>2'</i>	<i>5'</i>	<i>.008</i>
Screen Type	Depth to Bottom - Feet	
<i>PVC</i>	<i>50'</i>	


GEOLOGIC DATA (Office Use Only)			
Surface Elev.	Geologic Unit	Unit Thickness	Depth to Top
Subs. SWL	Date	Analysis	Aquifer Test
Driller's Remarks			

DESCRIPTION OF FORMATIONS ENCOUNTERED	FROM	TO
<i>white sand</i>	<i>0</i>	<i>1</i>
<i>blue clay</i>	<i>1</i>	<i>44</i>
<i>gray coarse sand</i>	<i>44</i>	<i>50</i>
<i>pea gravel</i>		

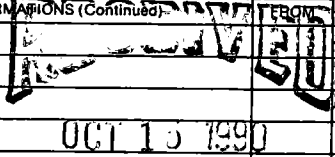FORMATIONS (Continued)	FROM	TO
		
OCT 15 1990		
Department of Natural Resources Bureau of Land & Water Resources		
IF MORE SPACE IS NEEDED, USE BACK		

If well telescopes please sketch and show depths.

GROUND LEVEL

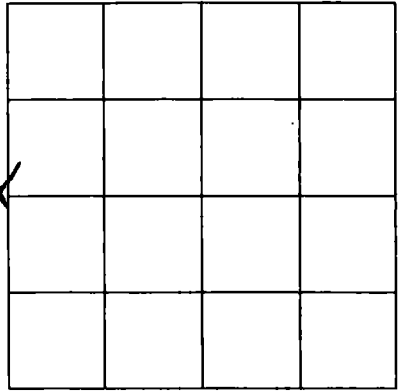

SECTION 18

Please indicate well location X.

ADDITIONAL INFORMATION

Lined area for additional information.

If more than one screen, show location of each on sketch.