

MISSISSIPPI DEPARTMENT OF NATURAL RESOURCES

Bureau of Land and Water Resources

P.O. Box 10631

Jackson, Mississippi 39209

WATER WELL DRILLERS LOG

COUNTY WELL LOCATED JACKSON
WELL NUMBER CODED N 2372
DATE WELL COMPLETED 21 AUG 90

PERMIT NUMBER 0-485
NAME OF DRILLING FIRM CORETEC
WRIGHT

NAME & MAILING ADDRESS OF LANDOWNER MR. BEN WEBB, JR.		
7705 TROUT RD		
OCEAN SPRINGS, MS 39564		
WELL LOCATION: SEC	TOWNSHIP	RANGE
13	7	N 8 E
DISTANCE	DIRECTION	NEAREST TOWN
4 Miles	N/EAST	OCEAN SPRINGS
OTHER LANDMARK 1/4 Mile SOUTH I-10		
WELL PURPOSE: Home, Irrigation, Municipal, Industrial, Fish Pond, etc. Home		

PUMP DATA		
PUMP TYPE (Circle One): Submersible, Turbine, (Jst) Flowing Well, Other (Describe) _____		
POWER TYPE (Circle One): (Electric) Tractor, Diesel, Gasoline, Butane, Other (Describe) _____ H/P 1/2		
Pump Capacity (GPM)	No. of Stages	Setting Depth
10	1	40 FT.
PUMP TEST		
Well yielded 8 GPM with a drawdown of 20 ft. after 2 hours of pumping		

WELL DATA		
Well Depth 100'	Casing Diameter (In.) 2"	Casing Length (Ft.) 90'
Type of Casing PVC	Hole Depth 104'	Depth to Static Water Level ARTESIAN FLOW
TYPE OF COMPLETION: (Circle One or More): Gravel Packed, Underreamed, Telescoped, (Natural Development) , Open Hole, Other		
Top of Lap Pipe or Reduction in Casing FEET IF TELESCOPED OR MORE THAN ONE SCREEN: USE BACK PAGE		

LOG DATA	
TYPE OF LOG RUN (Circle One): (No Log Run) Electric, Gamma Ray, Density, Sonic, Neutron, Other (Describe) _____	
Name of Organization Running Log	

SCREEN DATA		
Diameter - Inches 2"	Length - Feet 10'	Slot Size - Inches .010
Screen Type PVC cut	Depth to Bottom - Feet 90'-100'	


GEOLOGIC DATA (Office Use Only)			
Surface Elev.	Geologic Unit	Unit Thickness	Depth to Top
Subs. SWL	Date	Analysis	Aquifer Test
Driller's Remarks Well Flowed 3-5 GPM 2' above Surface / TOP 12' GROUTED IN W. PORTLAND CEMENT, Neat MIX			

DESCRIPTION OF FORMATIONS ENCOUNTERED	FROM	TO
TOP Soil	0	2'
Red Clay	2'	9'
White Sand	9'	18'
SAND-CLAY-Mud MIX	18'	27'
HARD DARK GRAY CLAY	27'	35'
SAND(FINE)+ MUD MIX	35'	70'
HARD GRAY CLAY	70'	81'
FINE-MED SAND	81'	101'
COURSE SAND	101'	104'
GRAY MUD	104'	→

FORMATIONS (Continued)	FROM	TO
<div style="font-size: 2em; font-weight: bold; opacity: 0.5;">RECEIVED</div> <div style="font-size: 1.5em; font-weight: bold; margin-top: 10px;">OCT 15 1990</div> <div style="font-size: 0.8em; margin-top: 20px;"> Department of Natural Resources Bureau of Land & Water Resources </div>		
IF MORE SPACE IS NEEDED, USE BACK		

If well telescopes please sketch and show depths.

GROUND LEVEL

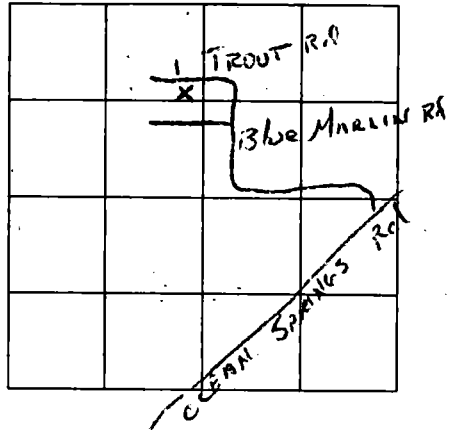

SECTION _____

Please indicate well location X.

ADDITIONAL INFORMATION

If more than one screen, show location of each on sketch.