

MISSISSIPPI DEPARTMENT OF NATURAL RESOURCES

Bureau of Land and Water Resources

Southport Mall

P.O. Box 10631

Jackson, Mississippi 39209

WATER WELL DRILLERS LOG

JACKSON
N 2376

8/17
date well completed

1989

Stringer Son
firm name

JACKSON
county well located

LANDOWNER: Mr. Kirk Hale

description of formations encountered

from to

Top soil
sand

0' 3'

Blue clay

3' 38'

SAND

38' 230'

260'
Hole

(mailing address)

WELL LOCATION:



_____ miles _____ of _____
(distance) (direction) (nearest town)

WELL PURPOSE: Home
(home, irrigation, municipal, industrial)

WELL COMPLETION DATA:

- (1) diameter (inches) 2"
- (2) total depth (feet) 260'
- (3) static water level (feet) 30' ^{below}/_{above} top of ground.

(4) casing 2" 250' cl
(material) (depth)

_____ if telescope see back.
(size)

(5) screen 10' 250'
(length) (depth to top)

2" PVC
(size) (material)


(6) pump 1 12
(HP) (yield gpm)

SRCFA
(type power)

(7) electric log No
(yes or no)

_____ (organization running log)

(8) how well bottom plugged PVC
Back Wash valve

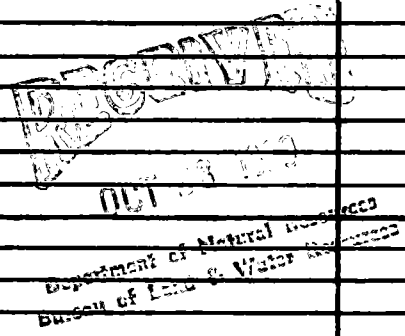

DRILLERS REMARKS:

If well telescopes please sketch and show depths.

GROUND LEVEL

SECTION _____

Please indicate well location X.

ADDITIONAL INFORMATION

If more than one screen, show locations of each on sketch.