

MISSISSIPPI DEPARTMENT OF ENVIRONMENTAL QUALITY
Bureau of Land and Water Resources

P. O. Box 10631
Jackson, MS 39289-0631
WATER WELL DRILLERS LOG

COUNTY WELL LOCATED
Jackson

WELL NUMBER CODED
22371

DATE WELL COMPLETED
11-2-90

PERMIT NUMBER

NAME OF DRILLING FIRM
Coast Water Well, Ser. Inc.

NAME & MAILING ADDRESS OF LANDOWNER
Lloyd Strait

Old Fort Bayou Rd.

Ocean Springs, Ms 39564

WELL LOCATION: SEC *9* TOWNSHIP *7^N* RANGE *8^W*

DISTANCE *3* Miles DIRECTION *N* of NEAREST TOWN *OCEAN SPRINGS*

OTHER LANDMARK

WELL PURPOSE: Home Irrigation, Municipal, Industrial, Fish Pond, etc.

PUMP DATA

PUMP TYPE (Circle One):
Submersible, Turbine, Jet, Flowing Well,
Other (Describe) _____

POWER TYPE (Circle One):
 Electric, Tractor, Diesel, Gasoline, Butane,
Other (Describe) _____ H/P *1*

Pump Capacity (GPM) *6* No. of Stages *2* Setting Depth _____ FT.

PUMP TEST

Well yielded _____ GPM with
a drawdown of _____ ft.
after _____ hours of pumping

WELL DATA

Well Depth <i>390'</i>	Casing Diameter (In.) <i>2"</i>	Casing Length (Ft.) <i>382'</i>
Type of Casing <i>PVC</i>	Hole Depth <i>395'</i>	Depth to Static Water Level <i>90'</i>

TYPE OF COMPLETION: (Circle One or More):
 Gravel Packed, Underreamed, Telescoped,
 Natural Development, Open Hole, Other
(Describe) _____

Top of Lap Pipe or Reduction in Casing

FEET IF TELESKOPED OR MORE THAN ONE SCREEN: USE BACK PAGE

LOG DATA

TYPE OF LOG RUN (Circle One):
No Log Run, Electric, Gamma Ray, Density, Sonic, Neutron,
Other (Describe) _____

Name of Organization Running Log

SCREEN DATA

Diameter - Inches <i>2"</i>	Length - Feet <i>10'</i>	Slot Size - Inches <i>.008</i>
Screen Type <i>PVC</i>	Depth to Bottom - Feet <i>392'</i>	

GEOLOGIC DATA (Office Use Only)

Surface Elev.	Geologic Unit	Unit Thickness	Depth to Top
Subs. SWL	Date	Analysis	Aquifer Test

Driller's Remarks

DESCRIPTION OF FORMATIONS ENCOUNTERED	FROM	TO	FORMATIONS (Continued)	FROM	TO
<i>Top soil</i>	<i>0</i>	<i>2</i>			
<i>Gray Clay</i>	<i>2</i>	<i>18</i>			
<i>Coarse sand</i>	<i>18</i>	<i>35</i>			
<i>Blue Clay streak of sand</i>	<i>35</i>	<i>160</i>			
<i>Fine sand</i>	<i>160</i>	<i>203</i>			
<i>Blue Clay streak of sand</i>	<i>203</i>	<i>345</i>			
<i>Fine sand</i>	<i>345</i>	<i>370</i>			
<i>Coarse sand</i>	<i>370</i>	<i>395</i>			

RECEIVED


JAN 11 1991

Dept. of Environmental Quality
Bureau of Land & Water Resources

IF MORE SPACE IS NEEDED USE BACK

If well telescopes please
sketch and show depths.

GROUND LEVEL

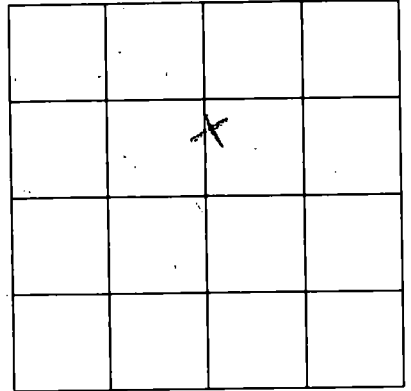

SECTION 9

Please indicate well location X.

ADDITIONAL INFORMATION

If more than one screen,
show location of each on sketch.