

MISSISSIPPI DEPARTMENT OF ENVIRONMENTAL QUALITY
Bureau of Land and Water Resources

P. O. Box 10631
Jackson, MS 39289-0631
WATER WELL DRILLERS LOG

COUNTY WELL LOCATED <i>Jackson</i>	
WELL NUMBER <i>N 2380</i>	CODED
DATE WELL COMPLETED <i>2-8-91</i>	

PERMIT NUMBER
NAME OF DRILLING FIRM <i>Coast Water Well Ser. Inc.</i>

NAME & MAILING ADDRESS OF LANDOWNER <i>Johnny Hollis</i>		
<i>Cook Rd</i>		
<i>Ocean Springs Ms.</i>		
WELL LOCATION: SEC	TOWNSHIP	RANGE
<i>3</i>	<i>7</i>	<i>9</i>
DISTANCE <i>4</i> Miles	DIRECTION <i>NW</i>	NEAREST TOWN <i>Ocean Springs</i>
OTHER LANDMARK		
WELL PURPOSE: <input checked="" type="radio"/> Home, <input type="radio"/> Irrigation, <input type="radio"/> Municipal, <input type="radio"/> Industrial, <input type="radio"/> Fish Pond, etc.		

PUMP DATA		
PUMP TYPE (Circle One): Submersible, Turbine, <input checked="" type="radio"/> Jet, Flowing Well, Other (Describe) _____		
POWER TYPE (Circle One): <input checked="" type="radio"/> Electric, Tractor, Diesel, Gasoline, Butane, Other (Describe) _____ H/P <i>2</i>		
Pump Capacity (GPM) <i>12</i>	No. of Stages <i>3</i>	Setting Depth FT.
PUMP TEST		
Well yielded _____ GPM with a drawdown of _____ ft. after _____ hours of pumping		

WELL DATA		
Well Depth <i>447</i> <i>452'</i>	Casing Diameter (In.) <i>2"</i>	Casing Length (Ft.) <i>437'</i>
Type of Casing <i>PVC</i>	Hole Depth <i>452'</i>	Depth to Static Water Level <i>90'</i>
TYPE OF COMPLETION: (Circle One or More): <input checked="" type="radio"/> Gravel Packed, <input type="radio"/> Underreamed, <input type="radio"/> Telescoped, <input checked="" type="radio"/> Natural Development, <input type="radio"/> Open Hole, <input type="radio"/> Other		
Top of Lap Pipe or Reduction in Casing FEET <input type="checkbox"/> IF TELESCOPED OR MORE THAN ONE SCREEN: USE BACK PAGE		

LOG DATA	
TYPE OF LOG RUN (Circle One): Electric, Gamma Ray, Density, Sonic, <input checked="" type="radio"/> No Log Run, Neutron, Other (Describe) _____	
Name of Organization Running Log	

SCREEN DATA		
Diameter - Inches <i>2"</i>	Length - Feet <i>10'</i>	Slot Size - Inches <i>.008</i>
Screen Type <i>PVC</i>	Depth to Bottom - Feet <i>447'</i>	

GEOLOGIC DATA (Office Use Only)			
Surface Elev.	Geologic Unit	Unit Thickness	Depth to Top
Subs. SWL	Date	Analysis	Aquifer Test
Driller's Remarks			

DESCRIPTION OF FORMATIONS ENCOUNTERED	FROM	TO	FORMATIONS (Continued)	FROM	TO
<i>Top soil</i>	<i>0</i>	<i>1</i>			
<i>Brown med. sand</i>	<i>1</i>	<i>8</i>			
<i>Gray Clay</i>	<i>8</i>	<i>35</i>			
<i>White coarse sand/gravel</i>	<i>35</i>	<i>44</i>			
<i>Blue Clay</i>	<i>44</i>	<i>250</i>			
<i>Big Clay (thick) of Fairmont</i>	<i>250</i>	<i>275</i>			
<i>Blue Clay</i>	<i>275</i>	<i>400</i>			
<i>Gray coarse sand</i>	<i>400</i>	<i>447</i>			
<i>Black Clay</i>	<i>447</i>	<i>452</i>			

RECEIVED


MAY 20 1991

Dept. of Environmental Quality
Bureau of Land & Water Resources

IF MORE SPACE IS NEEDED, USE BACK

If well telescopes please
sketch and show depths.

GROUND LEVEL

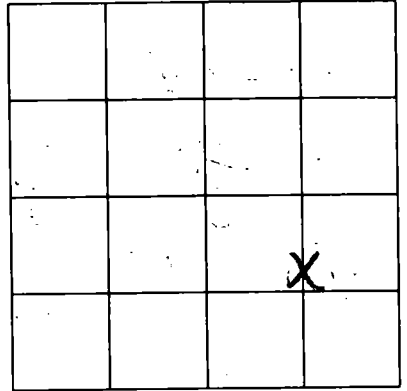

SECTION 3

Please indicate well location X.

ADDITIONAL INFORMATION

If more than one screen,
show location of each on sketch.