

MISSISSIPPI DEPARTMENT OF ENVIRONMENTAL QUALITY
Bureau of Land and Water Resources

P. O. Box 10631
Jackson, MS 39289-0631
WATER WELL DRILLERS LOG

COUNTY WELL LOCATED <i>Jackson</i>	
WELL NUMBER <i>2391</i>	CODED
DATE WELL COMPLETED <i>1-22-92</i>	

PERMIT NUMBER
NAME OF DRILLING FIRM <i>Coast Water Well Ser Inc.</i>

NAME & MAILING ADDRESS OF LANDOWNER <i>Arthur Webber</i>			
WELL LOCATION: SEC _____ TOWNSHIP _____ RANGE _____			
DISTANCE <i>1 1/2</i> Miles	DIRECTION <i>North</i>	NEAREST TOWN <i>O. Springs</i>	
OTHER LANDMARK			
WELL PURPOSE: <input checked="" type="checkbox"/> Home Irrigation, <input type="checkbox"/> Municipal, <input type="checkbox"/> Industrial, <input type="checkbox"/> Fish Pond, etc.			

PUMP DATA		
PUMP TYPE (Circle One): Submersible _____ Turbine _____ Jet _____ Flowing Well _____ Other (Describe) _____		
POWER TYPE (Circle One): Electric _____ Tractor _____ Diesel _____ Gasoline _____ Butane _____ Other (Describe) _____		
Pump Capacity (GPM)	No. of Stages	Setting Depth _____ FT.
PUMP TEST		
Well yielded _____ GPM with		a drawdown of _____ ft.
after _____ hours of pumping		

WELL DATA		
Well Depth <i>375'</i>	Casing Diameter (In.) <i>2"</i>	Casing Length (Ft.) <i>365'</i>
Type of Casing <i>PVC</i>	Hole Depth <i>375'</i>	Depth to Static Water Level <i>92'</i>
TYPE OF COMPLETION: (Circle One or More): Gravel Packed _____ Underreamed _____ Telescoped _____ Natural Development _____ Open Hole _____ Other _____ (Describe) _____		
Top of Lap Pipe or Reduction in Casing		
FEET	IF TELESCOPED OR MORE THAN ONE SCREEN: USE BACK PAGE	

LOG DATA	
TYPE OF LOG RUN (Circle One): Electric _____ Gamma Ray _____ Density _____ Sonic _____ Neutron _____ Other (Describe) _____	
Name of Organization Running Log	

SCREEN DATA		
Diameter - Inches <i>2"</i>	Length - Feet <i>10'</i>	Slot Size - Inches <i>.004</i>
Screen Type <i>PVC</i>	Depth to Bottom - Feet <i>375'</i>	

GEOLOGIC DATA (Office Use Only)			
Surface Elev.	Geologic Unit	Unit Thickness	Depth to Top
Subs. SWL	Date	Analysis	Aquifer Test


Driller's Remarks

DESCRIPTION OF FORMATIONS ENCOUNTERED	FROM	TO
<i>Top soil</i>	<i>0</i>	<i>2</i>
<i>Red clay</i>	<i>2</i>	<i>10</i>
<i>Coarse sand</i>	<i>10</i>	<i>25</i>
<i>Gray clay</i>	<i>25</i>	<i>45</i>
<i>Coarse sand</i>	<i>45</i>	<i>70</i>
<i>Blue clay</i>	<i>70</i>	<i>180</i>
<i>Med. sand</i>	<i>180</i>	<i>210</i>
<i>Blue clay</i>	<i>210</i>	<i>230</i>
<i>fine sand</i>	<i>230</i>	<i>250</i>
<i>Blue clay sand</i>	<i>250</i>	<i>350</i>
<i>fine sand</i>	<i>350</i>	<i>375</i>

FORMATIONS (Continued)	FROM	TO
RECEIVED		
MAR 23 1992		
Dept. of Environmental Quality Bureau of Land & Water Resources		
IF MORE SPACE IS NEEDED, USE BACK		

If well telescopes please sketch and show depths.

GROUND LEVEL

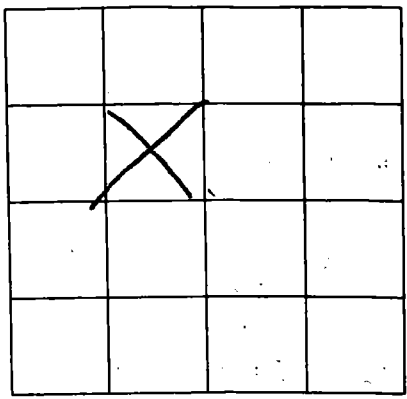

SECTION: _____

Please indicate well location X.

ADDITIONAL INFORMATION

Lined area for additional information.

RECEIVED

Handwritten notes at the bottom left.

If more than one screen, show location of each on sketch.