

**MISSISSIPPI DEPARTMENT OF ENVIRONMENTAL QUALITY**  
Bureau of Land and Water Resources

P. O. Box 10631  
Jackson, MS 39289-0631  
**WATER WELL DRILLERS LOG**

COUNTY WELL LOCATED <b>Jackson</b>	
WELL NUMBER <b>N 2392</b>	CODED
DATE WELL COMPLETED <b>3-3-92</b>	

PERMIT NUMBER
NAME OF DRILLING FIRM <b>Const. Water Well Driller Inc.</b>

NAME & MAILING ADDRESS OF LANDOWNER <b>Dan Tyler</b>			
WELL LOCATION: SEC <u>13</u> TOWNSHIP <u>N 8 E</u> RANGE <u>8 W</u>			
DISTANCE <u>3</u> Miles	DIRECTION <u>northeast</u>	NEAREST TOWN <u>AS</u>	
OTHER LANDMARK			
WELL PURPOSE: <input type="checkbox"/> Home, <input type="checkbox"/> Irrigation, <input type="checkbox"/> Municipal, <input type="checkbox"/> Industrial, <input type="checkbox"/> Fish Pond, etc.			

PUMP DATA		
PUMP TYPE (Circle One): Submersible, Turbine, Jet, Flowing Well, Other (Describe)		
POWER TYPE (Circle One): Electric, Tractor, Diesel, Gasoline, Butane, Other (Describe) <u>H/P</u>		
Pump Capacity (GPM)	No. of Stages	Setting Depth FT.
PUMP TEST		
Well yielded _____ GPM with		
a drawdown of _____ ft.		
after _____ hours of pumping		

WELL DATA		
Well Depth <b>340'</b>	Casing Diameter (In.) <b>4"</b>	Casing Length (Ft.) <b>320'</b>
Type of Casing <b>PVC</b>	Hole Depth <b>344'</b>	Depth to Static Water Level <b>48'</b>
TYPE OF COMPLETION: (Circle One or More): <input type="checkbox"/> Gravel Packed, <input type="checkbox"/> Underreamed, <input type="checkbox"/> Telescoped, <input type="checkbox"/> Natural Development, <input type="checkbox"/> Open Hole, <input type="checkbox"/> Other		
Top of Lap Pipe or Reduction in Casing		
FEET		
IF TELESCOPED OR MORE THAN ONE SCREEN: USE BACK PAGE		

LOG DATA	
TYPE OF LOG RUN (Circle One): Electric, Gamma Ray, Density, Sonic, Neutron, Other (Describe) <u>No Log Run.</u>	
Name of Organization Running Log	

SCREEN DATA		
Diameter - Inches <b>4"</b>	Length - Feet <b>20'</b>	Slot Size - Inches <b>.008</b>
Screen Type <b>PVC</b>	Depth to Bottom - Feet <b>340'</b>	

GEOLOGIC DATA (Office Use Only)			
Surface Elev.	Geologic Unit	Unit Thickness	Depth to Top
Subs. SWL	Date	Analysis	Aquifer Test


Driller's Remarks

DESCRIPTION OF FORMATIONS ENCOUNTERED	FROM	TO
<b>top soil</b>	<b>0</b>	<b>2</b>
<b>shale</b>	<b>2</b>	<b>10</b>
<b>fine sand</b>	<b>10</b>	<b>15</b>
<b>med. sand</b>	<b>15</b>	<b>20</b>
<b>blue clay</b>	<b>20</b>	<b>67</b>
<b>coarse sand</b>	<b>67</b>	<b>100</b>
<b>blue clay soft sand</b>	<b>100</b>	<b>318</b>
<b>med. sand</b>	<b>318</b>	<b>340</b>
<b>blue clay</b>	<b>340</b>	<b>344</b>

FORMATIONS (Continued)	FROM	TO
<b>RECEIVED</b>		
<b>MAR 23 1992</b>		
Dept. of Environmental Quality Bureau of Land & Water Resources		
IF MORE SPACE IS NEEDED, USE BACK		

If well telescopes please sketch and show depths.

GROUND LEVEL

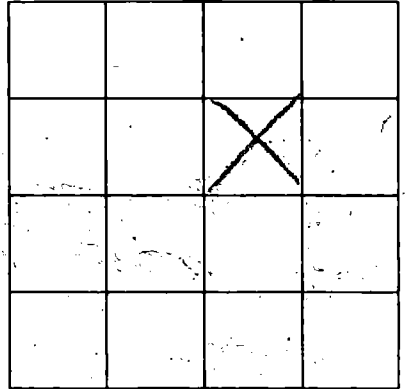

SECTION \_\_\_\_\_

Please indicate well location X.

ADDITIONAL INFORMATION

Lined area for additional information.

If more than one screen, show location of each on sketch.