

**MISSISSIPPI DEPARTMENT OF ENVIRONMENTAL QUALITY**  
Bureau of Land and Water Resources

P. O. Box 10631  
Jackson, MS 39289-0631  
**WATER WELL DRILLERS LOG**

COUNTY WELL LOCATED <i>Jackson</i>	
WELL NUMBER <i>N 7395</i>	CODED
DATE WELL COMPLETED <i>8-18-89</i>	

PERMIT NUMBER
<b>Coastal Drilling &amp; Service Co.</b> 8456 Woolmarkert Biloxi Road Biloxi, Mississippi 39532

NAME & MAILING ADDRESS OF LANDOWNER <i>Jack Anderson</i> <i>Jim Herald Road</i> <i>Ocean Springs Ms</i>		
WELL LOCATION: SEC	TOWNSHIP	RANGE
<i>Jackson 10</i>	<i>7 N</i>	<i>8 W</i>
DISTANCE	DIRECTION	NEAREST TOWN
<i>2</i> Miles	<i>N</i>	of <i>Fort Bay</i>
OTHER LANDMARK <i>JTO</i>		
WELL PURPOSE (Home Irrigation, Municipal, Industrial, Fish Pond, etc.) <i>Home</i>		

<b>PUMP DATA</b>		
PUMP TYPE (Circle One): Submersible, Turbine, <b>Jet</b> Flowing Well, Other (Describe) _____		
POWER TYPE (Circle One): <b>Electric</b> , Tractor, Diesel, Gasoline, Butane, Other (Describe) _____ H/P _____		
Pump Capacity (GPM) <i>10</i>	No. of Stages <i>2</i>	Setting Depth <i>60</i> FT.
PUMP TEST Well yielded _____ <i>10</i> GPM with a drawdown of _____ <i>0</i> ft. after _____ <i>6</i> hours of pumping		

<b>WELL DATA</b>		
Well Depth <i>330'</i>	Casing Diameter (In.) <i>2"</i>	Casing Length (Ft.) <i>320'</i>
Type of Casing <i>PVC</i>	Hole Depth <i>330'</i>	Depth to Static Water Level <i>40'</i>
TYPE OF COMPLETION: (Circle One or More): <b>Natural Development</b> , Underreamed, Telescoped, Open Hole, Other		
Top of Lap Pipe or Reduction in Casing  FEET IF TELESCOPED OR MORE THAN ONE SCREEN: USE BACK PAGE		

<b>LOG DATA</b>	
TYPE OF LOG RUN (Circle One): No Log Run, Electric, Gamma Ray, Density, Sonic, Neutron, Other (Describe) _____	
Name of Organization Running Log	

<b>SCREEN DATA</b>		
Diameter - Inches <i>2"</i>	Length - Feet <i>10'</i>	Slot Size - Inches <i>.008</i>
Screen Type <i>PVC</i>	Depth to Bottom - Feet <i>330'</i>	


<b>GEOLOGIC DATA (Office Use Only)</b>			
Surface Elev.	Geologic Unit	Unit Thickness	Depth to Top
Subs. SWL	Date	Analysis	Aquifer Test
Driller's Remarks <i>None</i>			

DESCRIPTION OF FORMATIONS ENCOUNTERED	FROM	TO
<i>top soil</i>	<i>1'</i>	<i>3'</i>
<i>Red sand</i>	<i>3'</i>	<i>12'</i>
<i>White sand</i>	<i>12'</i>	<i>22'</i>
<i>soft Blue clay</i>	<i>22'</i>	<i>85'</i>
<i>hard Blue clay</i>	<i>85'</i>	<i>220'</i>
<i>fine water sand</i>	<i>220'</i>	<i>260'</i>
<i>hard Blue clay</i>	<i>260'</i>	<i>300'</i>
<i>fine water sand</i>	<i>300'</i>	<i>330'</i>

FORMATIONS (Continued)	FROM	TO
<b>RECEIVED</b>		
<i>MAR 02 1992</i>		
Dept. of Environmental Quality Bureau of Land & Water Resources		
IF MORE SPACE IS NEEDED, USE BACK		

If well telescopes please sketch and show depths.

GROUND LEVEL

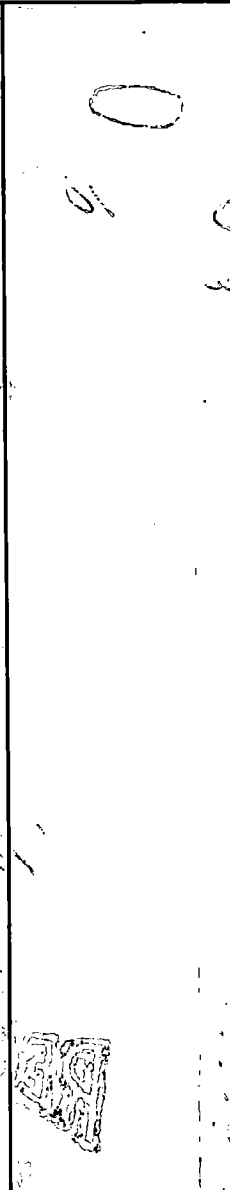


SECTION \_\_\_\_\_

Please indicate well location X's

ADDITIONAL INFORMATION

Handwritten notes and a sketch of a well location on a grid. The sketch shows a circle with an 'X' inside, representing the well location. The notes are written in a cursive hand and include details about the well's construction and location.

Handwritten text, possibly a signature or name, written in a stylized, blocky font.

Handwritten text, possibly a date or location, written in a cursive hand.

Handwritten text, possibly a note or instruction, written in a cursive hand.

If more than one screen, show location of each on sketch.