

MISSISSIPPI DEPARTMENT OF ENVIRONMENTAL QUALITY
Bureau of Land and Water Resources

P. O. Box 10631
Jackson, MS 39289-0631
WATER WELL DRILLERS LOG

COUNTY WELL LOCATED <i>Jackson</i>
WELL NUMBER (CODED) <i>N2399</i>
DATE WELL COMPLETED <i>8-24-92</i>

PERMIT NUMBER
NAME OF DRILLING FIRM <i>Coast Water Well Dr. Inc.</i>

NAME & MAILING ADDRESS OF LANDOWNER <i>Curtis Mc. Daniels</i>			
WELL LOCATION: SEC <u>35</u> TOWNSHIP <u>7 N</u> RANGE <u>8 E</u>			
DISTANCE	DIRECTION	NEAREST TOWN	
<u>3</u> Miles	<u>SE</u>	<u>OS-</u>	
OTHER LANDMARK			
WELL PURPOSE: <input checked="" type="checkbox"/> Home Irrigation, <input type="checkbox"/> Municipal, <input type="checkbox"/> Industrial, <input type="checkbox"/> Fish Pond, etc.			

PUMP DATA		
PUMP TYPE (Circle One): Submersible, Turbine, <input checked="" type="radio"/> Jet, Flowing Well, Other (Describe) _____		
POWER TYPE (Circle One): <input checked="" type="radio"/> Electric, Tractor, Diesel, Gasoline, Butane, Other (Describe) _____ H/P <u>1</u>		
Pump Capacity (GPM) <u>7</u>	No. of Stages <u>2</u>	Setting Depth <u> </u> FT.
PUMP TEST		
Well yielded _____ GPM with a drawdown of _____ ft. after _____ hours of pumping		

WELL DATA		
Well Depth <u>430'</u>	Casing Diameter (In.) <u>2"</u>	Casing Length (Ft.) <u>417'</u>
Type of Casing <u>PVC</u>	Hoie Depth <u>430</u>	Depth to Static Water Level <u>62'</u>
TYPE OF COMPLETION: (Circle One or More): <input checked="" type="checkbox"/> Gravel Packed, <input type="checkbox"/> Underreamed, <input type="checkbox"/> Telescoped, <input checked="" type="checkbox"/> Natural Development, <input type="checkbox"/> Open Hole, <input type="checkbox"/> Other (Describe) _____		
Top of Lap Pipe or Reduction in Casing		
FEET	IF TELESCOPED OR MORE THAN ONE SCREEN: USE BACK PAGE	

LOG DATA	
TYPE OF LOG RUN (Circle One): Electric, Gamma Ray, Density, Sonic, <input checked="" type="radio"/> No Log Run, Neutron, Other (Describe) _____	
Name of Organization Running Log	

SCREEN DATA		
Diameter - Inches <u>2"</u>	Length - Feet <u>10'</u>	Slot Size - Inches <u>.008</u>
Screen Type <u>PVC</u>	Depth to Bottom - Feet <u>429'</u>	


GEOLOGIC DATA (Office Use Only)			
Surface Elev.	Geologic Unit	Unit Thickness	Depth to Top
Subs. SWL	Date	Analysis	Aquifer Test
Driller's Remarks			

DESCRIPTION OF FORMATIONS ENCOUNTERED	FROM	TO
<i>top soil</i>	<i>0</i>	<i>2</i>
<i>yellow clay</i>	<i>2</i>	<i>10</i>
<i>fine sand</i>	<i>10</i>	<i>20</i>
<i>blue clays of sand</i>	<i>20</i>	<i>114</i>
<i>coarse sand</i>	<i>114</i>	<i>150</i>
<i>blue clays of sand</i>	<i>150</i>	<i>405</i>
<i>coarse sand</i>	<i>405</i>	<i>430</i>

FORMATIONS (Continued)	FROM	TO
RECEIVED		
OCT 07 1992		
Dept. of Environmental Quality Bureau of Land & Water Resources		
IF MORE SPACE IS NEEDED, USE BACK		

If well telescopes please sketch and show depths.

GROUND LEVEL

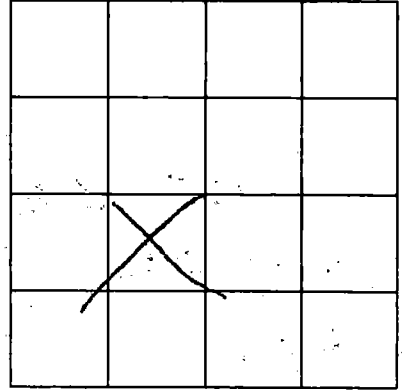

SECTION _____

Please indicate well location X.

ADDITIONAL INFORMATION

RECEIVED

DATE: _____
BY: _____

If more than one screen,
show location of each on sketch.