

MISSISSIPPI DEPARTMENT OF ENVIRONMENTAL QUALITY
Bureau of Land and Water Resources

P. O. Box 10631
Jackson, MS 39289-0631
WATER WELL DRILLERS LOG

COUNTY WELL LOCATED <i>Jackson</i>	
WELL NUMBER <i>N 7482</i>	CODED
DATE WELL COMPLETED <i>4-10-92</i>	

PERMIT NUMBER
NAME OF DRILLING FIRM <i>Coast Water Well Ser. Inc.</i>

NAME & MAILING ADDRESS OF LANDOWNER <i>Robert Corvi</i>			
WELL LOCATION: SEC <u>2</u> TOWNSHIP <u>8 N</u> RANGE <u>8 E</u>			
DISTANCE <u>3</u> Miles <u>SE</u> DIRECTION of <u>Ocean Springs</u> NEAREST TOWN			
OTHER LANDMARK			
WELL PURPOSE: <input checked="" type="checkbox"/> Home Irrigation, <input type="checkbox"/> Municipal, <input type="checkbox"/> Industrial, <input type="checkbox"/> Fish Pond, etc.			

PUMP DATA	
PUMP TYPE (Circle One): Submersible, Turbine, Jet, Flowing Well, Other (Describe)	
POWER TYPE (Circle One): Electric, Tractor, Diesel, Gasoline, Butane, Other (Describe) <u>H/P</u>	
Pump Capacity (GPM)	No. of Stages Setting Depth <u> </u> FT.
PUMP TEST	
Well yielded <u> </u> GPM with a drawdown of <u> </u> ft. after <u> </u> hours of pumping	

WELL DATA		
Well Depth <i>560'</i>	Casing Diameter (In.) <i>2"</i>	Casing Length (Ft.) <i>550'</i>
Type of Casing <i>PVC</i>	Hole Depth <i>570'</i>	Depth to Static Water Level <i>60'</i>
TYPE OF COMPLETION: (Circle One or More): <input checked="" type="checkbox"/> Gravel Packed, <input type="checkbox"/> Underreamed, <input type="checkbox"/> Telescoped, <input checked="" type="checkbox"/> Natural Development, <input type="checkbox"/> Open Hole, <input type="checkbox"/> Other (Describe)		
Top of Lap Pipe or Reduction in Casing		
FEET	IF TELESCOPED OR MORE THAN ONE SCREEN: USE BACK PAGE	

LOG DATA	
TYPE OF LOG RUN (Circle One): Electric, Gamma Ray, Density, Sonic, Neutron, <u>No Log Run</u> , Other (Describe)	
Name of Organization Running Log	

SCREEN DATA		
Diameter - Inches <i>2"</i>	Length - Feet <i>10'</i>	Slot Size - Inches <i>.004</i>
Screen Type <i>PVC</i>	Depth to Bottom - Feet <i>560'</i>	


GEOLOGIC DATA (Office Use Only)			
Surface Elev.	Top of Casing	Top of Screen	Depth to Top
Sybs. SWL	Analysis	Grain Test	
Driller's Remarks OCT 07 1992			
Dept. of Environmental Quality Bureau of Land & Water Resources			

DESCRIPTION OF FORMATIONS ENCOUNTERED	FROM	TO	FORMATIONS (Continued)	FROM	TO
<i>Top soil</i>	<i>0</i>	<i>2</i>	<i>Gray coarse sand</i>	<i>547</i>	<i>559</i>
<i>Gray clay</i>	<i>2</i>	<i>15</i>	<i>Blue clay</i>	<i>559</i>	<i>570</i>
<i>Coarse sand</i>	<i>15</i>	<i>50</i>			
<i>Blue clay</i>	<i>50</i>	<i>65</i>			
<i>Gray sand</i>	<i>65</i>	<i>75</i>			
<i>Coarse sandy</i>	<i>75</i>	<i>110</i>			
<i>Blue clay & sand</i>	<i>110</i>	<i>355</i>			
<i>fine sand</i>	<i>355</i>	<i>370</i>			
<i>Blue clay</i>	<i>370</i>	<i>473</i>			
<i>Blue clay & sand</i>	<i>473</i>	<i>511</i>			
<i>Gray fine sand</i>	<i>511</i>	<i>547</i>			

IF MORE SPACE IS NEEDED, USE BACK

If well telescopes please sketch and show depths.

GROUND LEVEL

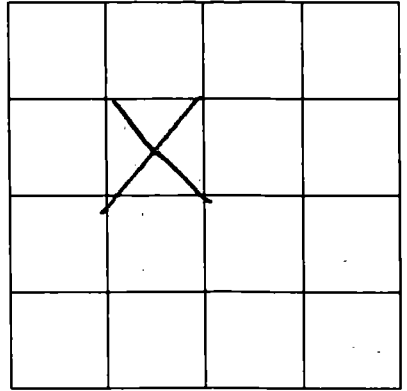

SECTION _____

Please indicate well location, X.

ADDITIONAL INFORMATION

Lined area for additional information.

RECEIVED

NOV 19 1955

U.S. GEOLOGICAL SURVEY
WATER RESOURCES DIVISION
WASHINGTON, D.C.

If more than one screen, show location of each on sketch.