

MISSISSIPPI DEPARTMENT OF ENVIRONMENTAL QUALITY
Bureau of Land and Water Resources

P. O. Box 10631
Jackson, MS 39289-0631
WATER WELL DRILLERS LOG

COUNTY WELL LOCATED <i>Jackson</i>	
WELL NUMBER <i>N 2403</i>	CODED
DATE WELL COMPLETED <i>6-5-92</i>	

PERMIT NUMBER
NAME OF DRILLING FIRM <i>Coast Water Well Dr. Inc.</i>

NAME & MAILING ADDRESS OF LANDOWNER <i>Lawrence Japp</i>			
WELL LOCATION: SEC <u>24</u> TOWNSHIP <u>7</u> RANGE <u>8</u> <i>(S) (W)</i>			
DISTANCE	DIRECTION	NEAREST TOWN	
<u>3</u> Miles	<u>NE</u>	of <u>OS.</u>	
OTHER LANDMARK			
WELL PURPOSE (Home) Irrigation, Municipal, Industrial, Fish Pond, etc.			

PUMP DATA		
PUMP TYPE (Circle One): Submersible, Turbine, Jet, Flowing Well, Other (Describe) _____		
POWER TYPE (Circle One): Electric, Tractor, Diesel, Gasoline, Butane, Other (Describe) _____ H/P _____		
Pump Capacity (GPM)	No. of Stages	Setting Depth FT.
PUMP TEST		
Well yielded _____		GPM with
a drawdown of _____		ft.
after _____		hours of pumping

WELL DATA		
Well Depth <i>569</i>	Casing Diameter (In.) <i>2"</i>	Casing Length (Ft.) <i>559</i>
Type of Casing <i>PVC</i>	Hole Depth <i>569</i>	Depth to Static Water Level <i>79'</i>
TYPE OF COMPLETION: (Circle One or More): Gravel Packed, Underreamed, Telescoped, Natural Development, Open Hole, Other (Describe) _____		
Top of Lap Pipe or Reduction in Casing FEET IF TELESCOPED OR MORE THAN ONE SCREEN: USE BACK PAGE		

LOG DATA	
TYPE OF LOG RUN (Circle One): Electric, Gamma Ray, Density, Sonic, Neutron, Other (Describe) _____	
Name of Organization Running Log <i>No Log Run</i>	

SCREEN DATA		
Diameter - Inches <i>2"</i>	Length - Feet <i>10'</i>	Slot Size - Inches <i>.008</i>
Screen Type <i>PVC</i>		Depth to Bottom - Feet <i>569</i>


GEOLOGIC DATA (Office Use Only)			
Surface Elev.	Geologic Unit	Unit Thickness	Depth to Top
Subs. SWL			Depth to Test
Driller's Remarks			
OCT 07 1992			
Dept. of Environmental Quality Bureau of Land & Water Resources			

DESCRIPTION OF FORMATIONS ENCOUNTERED	FROM	TO	FORMATIONS (Continued)	FROM	TO
<i>top soil</i>	<i>0</i>	<i>2</i>			
<i>yellow clay</i>	<i>2</i>	<i>12</i>			
<i>fine sand</i>	<i>12</i>	<i>20</i>			
<i>Blue Clay & Dupuy Clay</i>	<i>20</i>	<i>100</i>			
<i>Coarse sand</i>	<i>100</i>	<i>132</i>			
<i>Blue Clay & s of sand</i>	<i>132</i>	<i>290</i>			
<i>fine sand</i>	<i>290</i>	<i>315</i>			
<i>Blue Clay & s of sand</i>	<i>315</i>	<i>464</i>			
<i>Med. sand & s of clay</i>	<i>464</i>	<i>494</i>			
<i>s of sand - med</i>	<i>494</i>	<i>565</i>			
<i>fine sand</i>	<i>545</i>	<i>569</i>			

IF MORE SPACE IS NEEDED, USE BACK

If well telescopes please sketch and show depths.

GROUND LEVEL

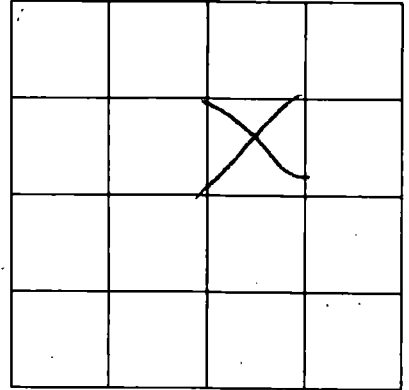

SECTION _____

Please indicate well location X.

ADDITIONAL INFORMATION

Multiple horizontal lines for providing additional information.

RECEIVED

Handwritten notes or stamps, possibly including a date and time.

If more than one screen, show location of each on sketch.