

MISSISSIPPI DEPARTMENT OF ENVIRONMENTAL QUALITY

Office of Land and Water Resources

P. O. Box 10631
Jackson, MS 39289-0631

WATER WELL DRILLERS LOG

COUNTY/WELL LOCATED <i>Jackson</i>	
WELL NUMBER <i>N 2419</i>	CODED
DATE WELL COMPLETED <i>7-13-93</i>	

PERMIT NUMBER
NAME OF DRILLING FIRM <i>Coast Water Well Dr. Inc.</i>

NAME & MAILING ADDRESS OF LANDOWNER <i>Lawrence Steelman</i>		
<i>Bayou Pine Dr.</i>		
<i>North Biloxi, Ms.</i>		
WELL LOCATION: SEC	TOWNSHIP	RANGE
<i>13</i>	<i>7 N</i>	<i>9 W</i>
DISTANCE	DIRECTION	NEAREST TOWN
<i>2</i> Miles	<i>EAST</i>	<i>DIBERVILLE</i>
OTHER LANDMARK		
WELL PURPOSE: <input checked="" type="checkbox"/> Home, <input type="checkbox"/> Irrigation, <input type="checkbox"/> Municipal, <input type="checkbox"/> Industrial, <input type="checkbox"/> Fish Pond, etc.		

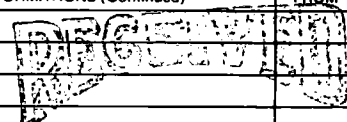
PUMP DATA		
PUMP TYPE (Circle One): Submersible, Turbine, <input checked="" type="radio"/> Jer, Flowing Well, Other (Describe) _____		
POWER TYPE (Circle One): <input checked="" type="radio"/> Electric, Tractor, Diesel, Gasoline, Butane, Other (Describe) <i>H/P 12</i>		
Pump Capacity (GPM) <i>6</i>	No. of Stages <i>1</i>	Setting Depth FT.
PUMP TEST		
Well yielded _____ GPM with a drawdown of _____ ft. after _____ hours of pumping		

WELL DATA		
Well Depth <i>240'</i>	Casing Diameter (In.) <i>2"</i>	Casing Length (Ft.) <i>227'</i>
Type of Casing <i>PVC</i>	Hole Depth <i>240'</i>	Depth to Static Water Level <i>30'</i>
TYPE OF COMPLETION: (Circle One or More): <input checked="" type="checkbox"/> Gravel Packed, <input type="checkbox"/> Underreamed, <input type="checkbox"/> Telescoped, <input checked="" type="checkbox"/> Natural Development, <input type="checkbox"/> Open Hole, <input type="checkbox"/> Other (Describe) _____		
WELL GROUTED TO A DEPTH OF <i>20</i> FEET Type Grout (circle one): <input checked="" type="checkbox"/> Cement, <input checked="" type="checkbox"/> Bentonite, or <input type="checkbox"/> Mix		

LOG DATA	
TYPE OF LOG RUN (Circle One): <input checked="" type="radio"/> No Log Run Electric, Gamma Ray, Density, Sonic, Neutron, Other (Describe) _____	
Name of Organization Running Log	

SCREEN DATA		
Diameter - Inches <i>2"</i>	Length - Feet <i>10'</i>	Slot Size - Inches <i>.008</i>
Screen Type <i>PVC</i>	Depth to Bottom - Feet <i>237'</i>	

GEOLOGIC DATA (Office Use Only)			
Surface Elev.	Geologic Unit	Unit Thickness	Depth to Top
Subs. SWL	Date	Analysis	Aquifer Test
Driller's Remarks <i>[Signature]</i>			

DESCRIPTION OF FORMATIONS ENCOUNTERED	FROM	TO	FORMATIONS (Continued)	FROM	TO
<i>Top soil</i>	<i>0</i>	<i>2</i>	 JUL 19 1993 Dept. of Environmental Quality Office of Land and Water Resources		
<i>Pink clay</i>	<i>2</i>	<i>30</i>			
<i>Coarse sand/gravel</i>	<i>30</i>	<i>50</i>			
<i>Blue/Black clay</i>	<i>50</i>	<i>125</i>			
<i>fine sand</i>	<i>125</i>	<i>130</i>			
<i>Blue clay</i>	<i>130</i>	<i>220</i>			
<i>Coarse sand</i>	<i>220</i>	<i>238</i>			
<i>Blue clay</i>	<i>238</i>	<i>240</i>			

IF MORE SPACE IS NEEDED, USE BACK

If well telescopes please
sketch and show depths.

GROUND LEVEL

X			

SECTION 13

Please indicate well location X.

ADDITIONAL INFORMATION

If more than one screen,
show location of each on sketch.