

**MISSISSIPPI DEPARTMENT OF ENVIRONMENTAL QUALITY**

Office of Land and Water Resources

P. O. Box 10631  
Jackson, MS 39289-0631  
**WATER WELL DRILLERS LOG**

COUNTY WELL LOCATED <i>Jackson</i>	
WELL NUMBER <i>N2420</i>	CODED
DATE WELL COMPLETED <i>8-17-93</i>	

PERMIT NUMBER
NAME OF DRILLING FIRM <i>Coast Water Well Service, Inc.</i>

NAME & MAILING ADDRESS OF LANDOWNER <i>David Sharp</i>		
<i>7601 Japp Rd.</i>		
<i>Ocean Springs, Ms.</i>		
WELL LOCATION: SEC	TOWNSHIP	RANGE
<i>24</i>	<i>7</i>	<i>8 E</i>
DISTANCE <i>1 1/2</i> Miles	DIRECTION <i>East</i>	NEAREST TOWN <i>Ocean Springs</i>
OTHER LANDMARK		
WELL PURPOSE <input checked="" type="radio"/> Home Irrigation, Municipal, Industrial, Fish Pond, etc.		

<b>PUMP DATA</b>		
PUMP TYPE (Circle One): Submersible, Turbine, <input checked="" type="radio"/> Jet, Flowing Well, Other (Describe)		
POWER TYPE (Circle One): <input checked="" type="radio"/> Electric, Tractor, Diesel, Gasoline, Butane, Other (Describe) H/P <input checked="" type="radio"/>		
Pump Capacity (GPM) <i>6</i>	No. of Stages <i>2</i>	Setting Depth  FT.
PUMP TEST		
Well yielded _____ GPM with a drawdown of _____ ft. after _____ hours of pumping		

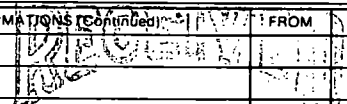
<b>WELL DATA</b>		
Well Depth <i>480'</i>	Casing Diameter (in.) <i>2"</i>	Casing Length (ft.) <i>472'</i>
Type of Casing <i>PVC 40</i>	Hole Depth <i>485</i>	Depth to Static Water Level <i>75'</i>
TYPE OF COMPLETION: (Circle One or More): <input checked="" type="radio"/> Gravel Packed, <input type="radio"/> Underreamed, <input type="radio"/> Telescoped, <input checked="" type="radio"/> Natural Development, <input type="radio"/> Open Hole, <input type="radio"/> Other (Describe)		
WELL GROUTED TO A DEPTH OF <i>20</i> FEET Type Grout (circle one): Cement, <input checked="" type="radio"/> Bentonite, or Mix		

<b>LOG DATA</b>	
TYPE OF LOG RUN (Circle One): Electric, Gamma Ray, Density, Sonic, Neutron, Other (Describe) <input checked="" type="radio"/> No Log Run.	
Name of Organization Running Log	

<b>SCREEN DATA</b>		
Diameter - Inches <i>2"</i>	Length - Feet <i>10'</i>	Slot Size - Inches <i>.008</i>
Screen Type <i>PVC SCH80</i>	Depth to Bottom - Feet <i>480</i>	

<b>GEOLOGIC DATA (Office Use Only)</b>			
Surface Elev.	Geologic Unit	Unit Thickness	Depth to Top
Subs. SWL	Date	Analysis	Aquifer Test
Driller's Remarks			

DESCRIPTION OF FORMATIONS ENCOUNTERED	FROM	TO	FORMATIONS ENCOUNTERED	FROM	TO
<i>Top Soil</i>	<i>0</i>	<i>2</i>			
<i>Medium sand</i>	<i>2</i>	<i>12</i>			
<i>Blue Clay</i>	<i>12</i>	<i>100</i>			
<i>Medium to coarse sand</i>	<i>100</i>	<i>135</i>			
<i>Blue Clay</i>	<i>135</i>	<i>330</i>			
<i>Fine sand</i>	<i>330</i>	<i>345</i>			
<i>Blue Clay</i>	<i>345</i>	<i>455</i>			
<i>Medium sand</i>	<i>455</i>	<i>465</i>			
<i>Coarse sand</i>	<i>465</i>	<i>480</i>			
<i>Blue Clay</i>	<i>480</i>	<i>485</i>			

  
 OCT 08 1993  
 Dept. of Environmental Quality  
 Office of Land & Water Resources

IF MORE SPACE IS NEEDED, USE BACK

If well telescopes please sketch and show depths.

GROUND LEVEL

		X	

SECTION 24

Please indicate well location X.

ADDITIONAL INFORMATION

If more than one screen,  
show location of each on sketch.