

MISSISSIPPI DEPARTMENT OF NATURAL RESOURCES

Bureau of Land and Water Resources

Southport Mall

P.O. Box 10631

Jackson, Mississippi 39209

WATER WELL DRILLERS LOG

Jackson
N
2439

4-7-82 date well completed *Cash Water Well Sew.* firm name *Jackson* county well located

LANDOWNER	description of formations encountered	from	to
<i>Rh 3. Box 223</i>	<i>Top soil</i>	<i>0</i>	<i>2'</i>
<i>Ocean Springs</i> (mailing address) <i>39164</i>	<i>Red Coarse sand</i>	<i>2'</i>	<i>60'</i>
<b>WELL LOCATION:</b> sec. <i>1</i> T. <i>8</i> N. R. <i>8</i> E <i>2</i> miles <i>SE</i> of <i>Ocean Springs</i> (distance) (direction) (nearest town)	<i>Blue Clay</i>	<i>60'</i>	<i>155'</i>
<b>WELL PURPOSE:</b> (home, irrigation, municipal, industrial)	<i>Blue Clay &amp; chunk of sand</i>	<i>155'</i>	<i>160'</i>
<b>WELL COMPLETION DATA:</b> (1) diameter (inches) <i>2"</i> (2) total depth (feet) <i>478'</i> (3) static water level (feet) <i>43'</i> below top of ground. (4) casing <i>PVC</i> ( <i>468'</i> ) (material) (depth) <i>2"</i> (size) if telescope see back. (5) screen <i>10'</i> ( <i>468'</i> ) (length) (depth to top) <i>2"</i> ( <i>PVC</i> ) (size) (material) (6) pump <i>1hp</i> ( <i>8</i> ) (type power) (yield gpm) <i>Elect.</i> (type power) (7) electric log <i>No.</i> (yes or no) (organization running log) (8) How well bottom plugged <i>Bad. Weak. Water</i>	<i>Blue Clay</i>	<i>160'</i>	<i>344'</i>
	<i>Blue Clay &amp; Struck</i>	<i>344'</i>	<i>370'</i>
	<i>Blue Clay</i>	<i>370'</i>	<i>455'</i>
	<i>Gray fine sand</i>	<i>455'</i>	<i>478'</i>

DRILLERS REMARKS:


DEPT. OF NATURAL RESOURCES  
BUREAU OF LAND & WATER RESOURCES

MAY 10 1982

RECEIVED

If well telescopes please sketch and show depths.

GROUND LEVEL

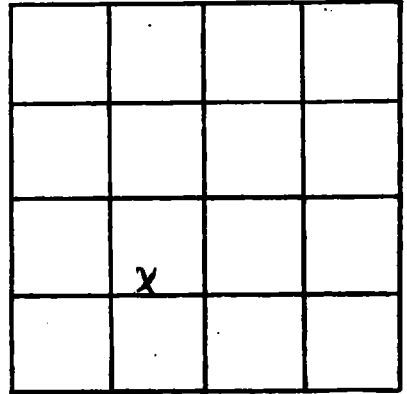

SECTION 1

Please indicate well location X.

ADDITIONAL INFORMATION

If more than one screen, show locations of each on sketch.