

MISSISSIPPI DEPARTMENT OF NATURAL RESOURCES

Bureau of Land and Water Resources

Southport Mall

P.O. Box 10631

Jackson, Mississippi 39209

COASTAL DRILLING SERVICE CO. DRILLERS LOG

ROUTE 1 BOX 618

BILOXI, MISS. 39532 name

Jackson county well located

Jackson
N
2470

4/21/82
date well completed

Bridgeport Co. Inc

Home
Eleon Spring Miss
(mailing address)

WELL LOCATION:
sec. 11 T. 8 S. R. 8 E. W. 5
Denton (Miss) beach
(distance) miles (direction) of (nearest town)

WELL PURPOSE:
home
(home, irrigation, municipal, industrial)

WELL COMPLETION DATA:

- (1) diameter (inches) 2"
- (2) total depth (feet) 400'
- (3) static water level (feet) 20' below top of ground
- (4) casing PVC, 390' (material), (depth)
- (size) If telescope see back.
- (5) screen 10' (length), 390' (depth to top)
- 2" (size), PVC (material)
- (6) pump 1/2 HP, 15 (yield gpm)
- 5/16 (type power)
- (7) electric log No (yes or no)

(organization running log)

(8) how well bottom plugged
Drillers Remarks: M-B

description of formations encountered	from	to
Top Soil	1	3
Red Soil	3	10
White Soggy Soil	10	60
Orange Soil	60	230
Soft Blue Clay	230	310
Hard Blue Clay	310	360
Grey wet soil	360	380
Good water sand	380	400


DEPT. OF NATURAL RESOURCES
BUREAU OF LAND & WATER RESOURCES

OCT 14 1982

RECEIVED

If well telescopes please sketch and show depths.

GROUND LEVEL

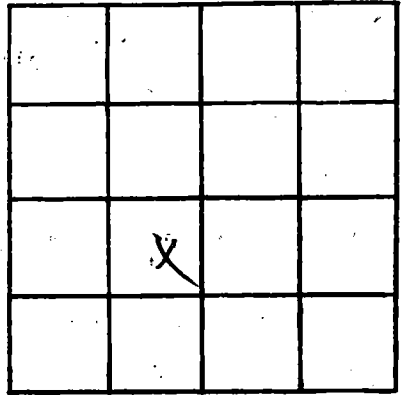

SECTION _____

Please indicate well location X.

ADDITIONAL INFORMATION

If more than one screen, show locations of each on sketch.