

MISSISSIPPI DEPARTMENT OF NATURAL RESOURCES

Bureau of Land and Water Resources

Southport Mall

P.O. Box 10631

Jackson, Mississippi 39209

WATER WELL DRILLERS LOG
COASTAL DRILLING & SERVICE CO.

ROUTE 1 BOX 618

firm name
BILLOXI, MISS. 39532

county well located

Jackson
N
2441

date well completed 19 *12/25/82*

LANDOWNER: *T. H. Queenport Jr.*

description of formations encountered	from	to
<i>Top Soil</i>	<i>1</i>	<i>2</i>
<i>Red Clay</i>	<i>2</i>	<i>10</i>
<i>Greyed Sand</i>	<i>10</i>	<i>210</i>
<i>Coarse white Sand</i>	<i>210</i>	<i>230</i>
<i>Soft Blue Clay</i>	<i>230</i>	<i>330</i>
<i>fine water sand</i>	<i>330</i>	<i>350</i>
<i>Hard Blue Clay</i>	<i>350</i>	<i>440</i>
<i>fine water sand</i>	<i>440</i>	<i>450</i>
<i>Coarse water sand</i>	<i>450</i>	<i>485</i>

Rt 3 Box #23
Ocean Springs 39564
(mailing address)

WELL LOCATION:

sec. *11* T. *8* N. R. *8* E. S. *3* W.
W. Moore Bogard
(distance) (direction) (nearest town)

WELL PURPOSE:

home
(home, irrigation, municipal, industrial)

WELL COMPLETION DATA:

- (1) diameter (inches) *4 1/2"*
- (2) total depth (feet) *485'*
- (3) static water level (feet) *30'* below top of ground.
- (4) casing *PVC* *470'*
(material) (depth)
4 1/2" if telescope see back.
(size)
- (5) screen *15'* *470'*
(length) (depth to top)
2" *PVC*
(size) (material)
- (6) pump *one* *20*
(HP) (yield gpm)
3/4
(type power)
- (7) electric log *no*
(yes or no)

(organization running log)

DEPT. OF NATURAL RESOURCES
BUREAU OF LAND & WATER RESOURCES

NOV 30 1982

RECEIVED

(8) check well bottom plugged
Robert W. Caldwell
DRILLERS REMARKS: *19-B*

If well telescopes please sketch and show depths.

GROUND LEVEL

160'-4" PK Casing


310'-2" PK Casing

15'-2" PK screen

2" backwash valve

19-13

If more than one screen, show locations of each on sketch.

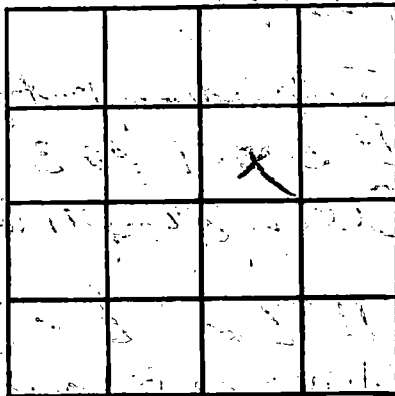

SECTION _____

Please indicate well location X.

ADDITIONAL INFORMATION

Additional information section with multiple horizontal lines for notes.