

MISSISSIPPI DEPARTMENT OF NATURAL RESOURCES

Bureau of Land and Water Resources

Southport Mall

P.O. Box 10631

Jackson, Mississippi 39209

WATER WELL DRILLERS LOG

Jasper
2442

7-6-83 19 *Coast Water Well Sew. Jackson*
date well completed firm name county well located

LANDOWNER *W.P. Kennedy IV*
P.O. Box 625
Ocean Springs, Miss
(mailing address) *39564*

description of formations encountered	from	to
<i>Top soil</i>	<i>0</i>	<i>5'</i>
<i>Blue Clay</i>	<i>5</i>	<i>55'</i>
<i>gray concrete sand</i>	<i>55</i>	<i>76'</i>

WELL LOCATION:
sec *3* T *8* N R *8* E
6 miles *SE* of *Ocean Springs*
(distance) (direction) (nearest town)

WELL PURPOSE: *Home*
(home, irrigation, municipal, industrial)

WELL COMPLETION DATA:

(1) diameter (inches) *2"*

(2) total depth (feet) *76'*

(3) static water level (feet) *4'* below above top of ground.

(4) casing *PVC* *66'*
(material) (depth)
2"
(size) If telescope see back.

(5) screen *10'* *66'*
(length) (depth to top)
2" *PVC*
(size) (material)

(6) pump *1/2 HP* *12*
(HP) (yield gpm)
Elect.
(type power)

(7) electric log *No.*
(yes or no)

(organization running log)

(8) How well bottom plugged
Back Wash Valve

DRILLERS REMARKS:


DEPT. OF NATURAL RESOURCES
BUREAU OF LAND & WATER RESOURCES

JUN 24 1983

RECEIVED

If well telescopes please sketch and show depths.

GROUND LEVEL

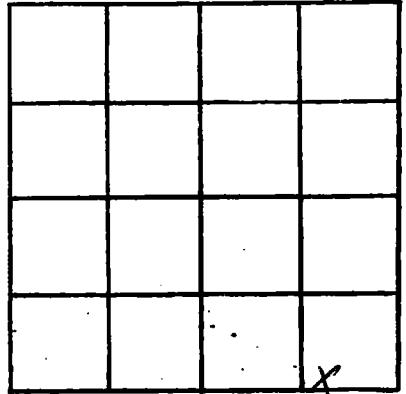

SECTION 13

Please indicate well location X.

ADDITIONAL INFORMATION

If more than one screen,
show locations of each on sketch.