

MISSISSIPPI DEPARTMENT OF NATURAL RESOURCES

Bureau of Land and Water Resources

Southport Mall

P.O. Box 10631

Jackson, Mississippi 39209

WATER WELL DRILLERS LOG

JACKSON  
N  
24~~44~~

10-24-85 19 Coast Water Well Jackson  
date well completed firm name county well located

LANDOWNER: Diane Mitchell

description of formations encountered	from	to
	Top Soil	0'
Red Clay	2'	10'
Blue Clay	10'	48'
White Coarse Sand	48'	115'
Blue Clay	115'	225'
8" Rock	225'	
Blue Clay	225'	320'
Blue Clay + streak of Sand	320'	400'
Blue fine sand	400'	415'
Blue Clay + streak of Sand	415'	430'
Gray Coarse Sand	430'	489'
Gray Coarse Sand + Gravel	489'	494'

103 LA Branch Ave

Ocean Springs, MS  
(mailing address) 39564


WELL LOCATION:

sec. 1 T. 8 N R. 8 E  
2 miles SE of OCEAN SPRINGS  
(distance) (direction) (nearest town)

WELL PURPOSE: home  
(home, irrigation, municipal, industrial)

WELL COMPLETION DATA:

- (1) diameter (inches) 2"
- (2) total depth (feet) 494'
- (3) static water level (feet) 51 below top of ground
- (4) casing PVC, 479' (material) (depth)  
2" (size) If telescope see back.
- (5) screen 10' 479' (length) (depth to top)  
2" (size) PVC (material)
- (6) pump 1/2 HP, 7 (type power) (yield gpm)
- (7) electric log no (yes or no)  
(organization running log)
- (8) how well bottom plugged Backwash valve

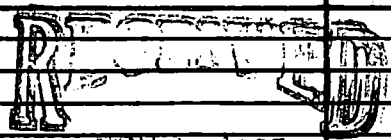


NOV 26 1985

DRILLERS REMARKS:  
5' - 2" PVC tailpipe

Department of Natural Resources  
Bureau of Land & Water Resources

If well telescopes please  
sketch and show depths.

GROUND LEVEL

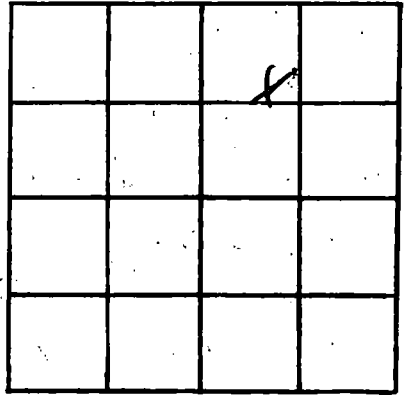

SECTION   /  

Please indicate well location X.

ADDITIONAL INFORMATION

If more than one screen,  
show locations of each on sketch.