

MISSISSIPPI DEPARTMENT OF NATURAL RESOURCES

Bureau of Land and Water Resources

Southport Mall

P.O. Box 10631

Jackson, Mississippi 39209

WATER WELL DRILLERS LOG

JACKSON
N
2485

10-25-85 Pierce Drilling Jackson  
 date well completed firm name county well located

LANDOWNER Rocky Meadows  
Hamilton Farm Rd.  
Passagoula, Ms  
 (mailing address)

description of formations encountered	from	to
Top Soil	0	10
Sand + Clay	10	50
good Sand	50	80
Clay	80	300
good Sand	300	320

WELL LOCATION:

sec. 7 T. 8 N. R. 8 E.  
2 miles North of Bay  
 (distance) (direction) (nearest town)

WELL PURPOSE:

(home, irrigation, municipal, industrial)

WELL COMPLETION DATA:

- (1) diameter (inches) 2"
- (2) total depth (feet) 320'
- (3) static water level (feet) 30' <sup>below</sup> top of ground
- (4) casing plastic, 310'  
 (material) (depth)  
0 If telescope see back.  
 (size)
- (5) screen 10, 320'  
 (length) (depth to top)  
006, plastic  
 (size) (material)
- (6) pump 1 10  
 (HP) (yield gpm)  
electric  
 (type power)
- (7) electric log (yes or no)  
 (organization running log)
- (8) how well bottom plugged BW


**RECEIVED**  
 NOV 19 1985

DRILLERS REMARKS:

Department of Natural Resources  
 Bureau of Land & Water Resources

If well telescopes please sketch and show depths.

GROUND LEVEL

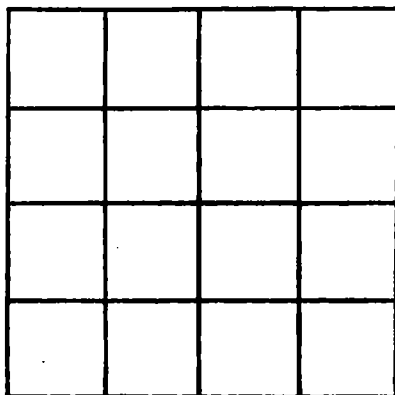

SECTION \_\_\_\_\_

Please indicate well location X.

ADDITIONAL INFORMATION

If more than one screen,  
show locations of each on sketch.