

875-7663

**MISSISSIPPI DEPARTMENT OF NATURAL RESOURCES**

Bureau of Land and Water Resources

COUNTY WELL LOCATED  
*Jackson*

WELL NUMBER CODED  
*N 2489*

DATE WELL COMPLETED  
*9-16-86*

PERMIT NUMBER

NAME OF DRILLING FIRM  
*Coast Water Well Sew.*

P.O. Box 10631  
Jackson, Mississippi 39209  
**WATER WELL DRILLERS LOG**

NAME & MAILING ADDRESS OF LANDOWNER  
*Russell Wood*

*7420 Fountainbleu Rd*

*Ocean Springs, MS. 39564*

WELL LOCATION: SEC TOWNSHIP RANGE  
*2 8 N 8 E*

DISTANCE DIRECTION NEAREST TOWN  
*3 Miles SW of Ocean Springs*

OTHER LANDMARK

WELL PURPOSE: Home, Irrigation, Municipal, Industrial, Fish Pond, etc.  
*home*

**PUMP DATA**

PUMP TYPE (Circle One):  
Submersible, Turbine, Jet, Flowing Well,  
Other (Describe) \_\_\_\_\_

POWER TYPE (Circle One):  
Electric, Tractor, Diesel, Gasoline, Butane,  
Other (Describe) \_\_\_\_\_

Pump Capacity (GPM) No. of Stages Setting Depth  
\_\_\_\_\_ FT.

PUMP TEST

Well yielded \_\_\_\_\_ GPM with  
a drawdown of \_\_\_\_\_ ft.  
after \_\_\_\_\_ hours of pumping

**WELL DATA**

Well Depth <i>358'</i>	Casing Diameter (In.) <i>2"</i>	Casing Length (Ft.) <i>343'</i>
Type of Casing <i>PVC</i>	Hole Depth <i>358'</i>	Depth to Static Water Level <i>36'</i>

TYPE OF COMPLETION: (Circle One or More):  
 Gravel Packed,  Underreamed,  Telescoped,  
 Natural Development,  Open Hole,  Other

Top of Lap Pipe or Reduction in Casing  
FEET IF TELESKOPED OR MORE THAN ONE SCREEN: USE BACK PAGE

**LOG DATA**

TYPE OF LOG RUN (Circle One):  
Electric, Gamma Ray, Density, Sonic,  No Log Run, Neutron,  
Other (Describe) \_\_\_\_\_

Name of Organization Running Log

**SCREEN DATA**

Diameter - Inches <i>2"</i>	Length - Feet <i>10'</i>	Slot Size - Inches <i>.010</i>
Screen Type <i>PVC</i>	Depth to Bottom - Feet <i>353</i>	

**GEOLOGIC DATA (Office Use Only)**

Surface Elev.	Geologic Unit	Unit Thickness	Depth to Top
Subs. SWL	Date	Analysis	Aquifer Test

Driller's Remarks

DESCRIPTION OF FORMATIONS ENCOUNTERED	FROM	TO
<i>Top soil</i>	<i>0</i>	<i>2'</i>
<i>Blue Clay &amp; streak of sand</i>	<i>2'</i>	<i>15'</i>
<i>Blue Clay</i>	<i>15'</i>	<i>170'</i>
<i>6" Blue Clay</i>	<i>170'</i>	<i>—</i>
<i>Blue Clay</i>	<i>170'</i>	<i>318'</i>
<i>Blue Clay &amp; streak of sand</i>	<i>—</i>	<i>—</i>
<i>of sand</i>	<i>318'</i>	<i>325'</i>
<i>gray coarse sand</i>	<i>325'</i>	<i>353'</i>
<i>Blue Clay &amp; streak of sand</i>	<i>—</i>	<i>—</i>
	<i>353'</i>	<i>358'</i>

**RECEIVED**

NOV 24 1986


Department of Natural Resources  
Bureau of Land & Water Resources

DESCRIPTION OF FORMATIONS (Continued) FROM TO

IF MORE SPACE IS NEEDED, USE BACK

If well telescopes please  
sketch and show depths.

GROUND LEVEL

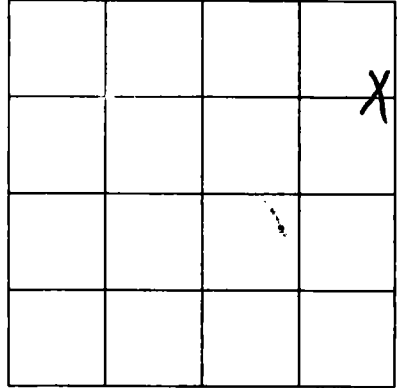

SECTION   A  

Please indicate well location X.

ADDITIONAL INFORMATION

If more than one screen,  
show location of each on sketch.