

**MISSISSIPPI DEPARTMENT OF ENVIRONMENTAL QUALITY**

Office of Land and Water Resources

P. O. Box 10631  
Jackson, MS 39289-0631  
**WATER WELL DRILLERS LOG**

COUNTY WELL LOCATED <i>Jackson</i>	
WELL NUMBER <i>N 2464</i>	CODED
DATE WELL COMPLETED <i>1-17-96</i>	

PERMIT NUMBER
NAME OF DRILLING FIRM <i>Coastwater Well Service</i>

NAME & MAILING ADDRESS OF LANDOWNER <i>Gino Agnelly</i> <i>Deer Rd</i> <i>Ocean Springs Ms</i>			
WELL LOCATION	SECTION	TOWNSHIP	RANGE
	<i>11</i>	<i>8 S</i>	<i>8 W</i>
DISTANCE	DIRECTION	NEAREST TOWN	
<i>3</i> Miles	<i>SE</i>	<i>Ocean Springs</i>	
OTHER LANDMARK			
WELL PURPOSE <input checked="" type="checkbox"/> Home Irrigation, Municipal, Industrial, Fish Pond, etc.			

<b>PUMP DATA</b>		
PUMP TYPE (Circle One): Submersible, Turbine, <input checked="" type="radio"/> Jet, Flowing Well, Other (Describe) _____		
POWER TYPE (Circle One): <input checked="" type="radio"/> Electric, Tractor, Diesel, Gasoline, Butane, Other (Describe) _____ H/P <i>2</i>		
Pump Capacity (GPM) <i>10</i>	No. of Stages <i>3</i>	Setting Depth  <b>FT.</b>
PUMP TEST		
Well yielded _____ GPM with a drawdown of _____ ft. after _____ hours of pumping		

<b>WELL DATA</b>		
Well Depth <i>615</i>	Casing Diameter (In.) <i>2"</i>	Casing Length (Ft.) <i>600'</i>
Type of Casing <i>PVC</i>	Hole Depth <i>615'</i>	Depth to Static Water Level <i>90'</i>
TYPE OF COMPLETION: (Circle One or More): <input checked="" type="checkbox"/> Gravel Packed, Underreamed, Telescoped, <input checked="" type="checkbox"/> Natural Development, Open Hole, Other		
WELL GROUTED TO A DEPTH OF <i>20</i> FEET Type Grout (circle one): Cement, Bentonite, or Mix		

<b>LOG DATA</b>	
TYPE OF LOG RUN (Circle One): Electric, Gamma Ray, Density, Sonic, Neutron, Other (Describe) _____	
Name of Organization Running Log	

<b>SCREEN DATA</b>		
Diameter - Inches <i>2"</i>	Length - Feet <i>15'</i>	Slot Size - Inches <i>.004</i>
Screen Type <i>PVC</i>	Depth to Bottom - Feet <i>615'</i>	


<b>GEOLOGIC DATA (Office Use Only)</b>			
Surface Elev.	Geologic Unit	Unit Thickness	Depth to Top
Subs. SWL	Date	Analysis	Aquifer Test
Driller's Remarks			
Top of Lap Pipe or Reduction in Casing			
<b>FEET</b>		IF TELESCOPED OR MORE THAN ONE SCREEN: USE BACK PAGE	

DESCRIPTION OF FORMATIONS ENCOUNTERED	FROM	TO
<i>Sand streaks clay</i>	<i>0</i>	<i>90</i>
<i>Blue Clay</i>	<i>90</i>	<i>140</i>
<i>Fine Med Sand</i>	<i>140</i>	<i>170</i>
<i>Blue clay streak sand</i>	<i>170</i>	<i>380</i>
<i>Med Sand</i>	<i>380</i>	<i>407</i>
<i>Blue Clay</i>	<i>407</i>	<i>430</i>
<i>Med Sand</i>	<i>430</i>	<i>455</i>
<i>Blue Clay</i>	<i>455</i>	<i>510</i>
<i>Med Sand</i>	<i>510</i>	<i>615</i>

FORMATIONS (Continued)	FROM	TO
<b>REGISTERED</b>		
<i>APR 01 1995</i>		
Dept. of Environmental Quality Office of Land & Water Resources		
IF MORE SPACE IS NEEDED, USE BACK		

If well telescopes please sketch and show depths.

GROUND LEVEL

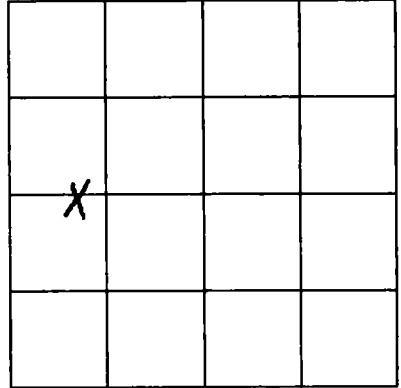

SECTION 11

Please indicate well location X.

ADDITIONAL INFORMATION

If more than one screen,  
show location of each on sketch.