

MISSISSIPPI DEPARTMENT OF ENVIRONMENTAL QUALITY

Office of Land and Water Resources

P. O. Box 10631
Jackson, MS 39289-0631

WATER WELL DRILLERS LOG

COUNTY WELL LOCATED
Jackson

WELL NUMBER CODED
N 2560

DATE WELL COMPLETED
1-7-99

PERMIT NUMBER

NAME OF DRILLING FIRM
Coastal Water Well Service

NAME & MAILING ADDRESS OF LANDOWNER *Mike Oakwood Homes Bunker*

Elm Street

Ocean Springs, Ms

WELL LOCATION SEC TOWNSHIP RANGE
2 8 8 E

DISTANCE DIRECTION NEAREST TOWN
1 Miles *SE* of *Ocean Springs*

OTHER LANDMARK

WELL PURPOSE Home, Irrigation, Municipal, Industrial, Fish Pond, etc.

PUMP DATA

PUMP TYPE (Circle One):
Submersible, Turbine, Jet, Flowing Well, Other (Describe) _____

POWER TYPE (Circle One):
 Electric, Tractor, Diesel, Gasoline, Butane, Other (Describe) _____ H/P *1*

Pump Capacity (GPM) No. of Stages Setting Depth
9.5 *2* _____ FT.

PUMP TEST

Well yielded _____ GPM with a drawdown of _____ ft. after _____ hours of pumping

WELL DATA

Well Depth Casing Diameter (In.) Casing Length (Ft.)
170' *2"* *160'*

Type of Casing Hole Depth Depth to Static Water Level
PVC *170'* *20'*

LOG DATA

TYPE OF LOG RUN (Circle One):
Electric, Gamma Ray, Density, Sonic, No Log Run, Neutron, Other (Describe) _____

Name of Organization Running Log

TYPE OF COMPLETION: (Circle One or More):
 Gravel Packed, Underreamed, Telescoped, Natural Development, Open Hole, Other

WELL GROUTED TO A DEPTH OF *20* FEET
Type Grout (circle one): Cement, Bentonite, or Mix

GEOLOGIC DATA (Office Use Only)

Surface Elev.	Geologic Unit	Unit Thickness	Depth to Top
Subs. SWL	Date	Analysis	Aquifer Test

SCREEN DATA

Diameter - Inches Length - Feet Slot Size - Inches
2" *10'* *.008*

Screen Type Depth to Bottom - Feet
PVC *170'*

Driller's Remarks

Top of Lap Pipe or Reduction in Casing

FEET IF TELESKOPED OR MORE THAN ONE SCREEN: USE BACK PAGE

DESCRIPTION OF FORMATIONS ENCOUNTERED	FROM	TO
<i>Top Soil</i>	<i>0</i>	<i>2</i>
<i>Blaux Clay</i>	<i>2</i>	<i>9</i>
<i>White Coars sand</i>	<i>9</i>	<i>35</i>
<i>Blue Clay</i>	<i>35</i>	<i>75</i>
<i>White coarse sand</i>	<i>75</i>	<i>90</i>
<i>Blue Clay</i>	<i>90</i>	<i>140</i>
<i>Med sand</i>	<i>140</i>	<i>170</i>

RECEIVED


APR 05 1999

Dept. of Environmental Quality
Office of Land & Water Resources

IF MORE SPACE IS NEEDED, USE BACK

If well telescopes please sketch and show depths.

GROUND LEVEL

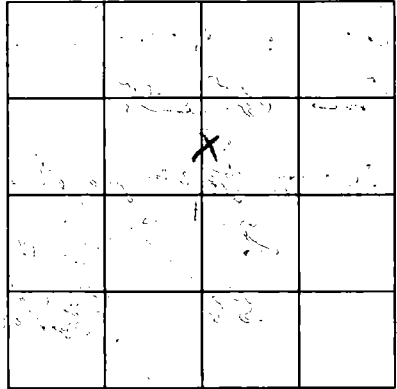

SECTION 2

Please indicate well location X.

ADDITIONAL INFORMATION

RECEIVED

APR 09 1989

STATE OF TEXAS
DEPT. OF LAND & WATER RESOURCES

If more than one screen,
show location of each on sketch.