

**MISSISSIPPI DEPARTMENT OF ENVIRONMENTAL QUALITY**

Office of Land and Water Resources

P. O. Box 10631  
Jackson, MS 39289-0631  
**WATER WELL DRILLERS LOG**

COUNTY WHERE LOCATED <i>Jackson</i>		PERMIT NUMBER
WELL NUMBER <i>N 2593</i>	CODED	NAME OF DRILLING COMPANY <i>Coast Water Well Service</i>
DATE WELL COMPLETED <i>9-22-99</i>		

NAME & MAILING ADDRESS OF LANDOWNER <i>Gemmy Owens</i>			
<i>North 6th Street</i>			
<i>Ocean Springs, Ms</i>			
WELL LOCATION	SEC	TOWNSHIP	RANGE
	<i>35</i>	<i>7</i>	<i>8</i>
DISTANCE	DIRECTION	NEAREST TOWN	
<i>2</i> Miles	<i>EAST</i>	<i>OCEAN SPRINGS</i>	
OTHER LANDMARK			
WELL PURPOSE: Home, Irrigation, Municipal, Industrial, Fish Pond, etc. <input checked="" type="checkbox"/> Home			

<b>PUMP DATA</b>		
PUMP TYPE (Circle One): Submersible, Turbine, <input checked="" type="radio"/> Flowing Well, Other (Describe) _____		
POWER TYPE (Circle One): <input checked="" type="radio"/> Electric, Tractor, Diesel, Gasoline, Butane, Other (Describe) _____ H/P <i>1</i>		
Pump Capacity (GPM) <i>8</i>	No. of Stages <i>2</i>	Setting Depth <i>FT.</i>
PUMP TEST Well yielded _____ GPM with a drawdown of _____ ft. after _____ hours of pumping		

<b>WELL DATA</b>		
Well Depth <i>283'</i>	Casing Diameter (In) <i>2"</i>	Casing Length (Ft.) <i>273'</i>
Type of Casing <i>PVC</i>	Hole Depth <i>283'</i>	Depth to Static Water Level <i>50'</i>

<b>LOG DATA</b>	
TYPE OF LOG RUN (Circle One): Electric, Gamma Ray, Density, Sonic, <input checked="" type="radio"/> No Log Run, Neutron, Other (Describe) _____	
Name of Organization Running Log	

TYPE OF COMPLETION: (Circle One or More): <input checked="" type="checkbox"/> Gravel Packed, <input type="checkbox"/> Underreamed, <input type="checkbox"/> Telescoped, <input checked="" type="checkbox"/> Natural Development, <input type="checkbox"/> Open Hole, <input type="checkbox"/> Other (Describe) _____			
WELL GROUTED TO A DEPTH OF <i>20</i> FEET Type Grout (circle one): Cement, Bentonite, or Mix			

<b>GEOLOGIC DATA (Office Use Only)</b>			
Surface Elev.	Geologic Unit	Unit Thickness	Depth to Top
Subs. SWL	Date	Analysis	Aquifer Test
Driller's Remarks			
Top of Lap Pipe or Reduction in Casing			
FEET IF TELESCOPED OR MORE THAN ONE SCREEN: USE BACK PAGE			


<b>SCREEN DATA</b>		
Diameter - Inches <i>2"</i>	Length - Feet <i>10'</i>	Slot Size - Inches <i>.008</i>
Screen Type <i>PVC</i>	Depth to Bottom - Feet <i>283'</i>	

DESCRIPTION OF FORMATIONS ENCOUNTERED	FROM	TO
<i>top soil</i>	<i>0</i>	<i>3</i>
<i>orange gray clay</i>	<i>3</i>	<i>15</i>
<i>Blue Clay</i>	<i>15</i>	<i>50</i>
<i>Med coarse sand</i>	<i>50</i>	<i>165</i>
<i>Blue Clay</i>	<i>165</i>	<i>268</i>
<i>Coarse Sand</i>	<i>268</i>	<i>283</i>

FORMATIONS (Continued)	FROM	TO
<b>RECEIVED</b>		
DEC 28 1999		
Dept of Environmental Quality Office of Land & Water Resources		
IF MORE SPACE IS NEEDED, USE BACK		

If well telescopes please sketch and show depths.

GROUND LEVEL

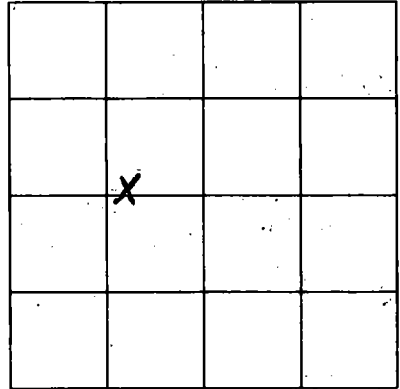

SECTION 35

Please indicate well location X.

ADDITIONAL INFORMATION

RECEIVED

Office of Land & Water Resources  
Dept. of Environmental Affairs

If more than one screen,  
show location of each on sketch.