

MISSISSIPPI DEPARTMENT OF ENVIRONMENTAL QUALITY
Office of Land and Water Resources

P. O. Box 10631
Jackson, MS 39289-0631
WATER WELL DRILLERS LOG

COUNTY WELL LOCATED
Jackson

WELL NUMBER: *W-244* CODED: _____

2692

DATE WELL COMPLETED: *10-18-00*

PERMIT NUMBER: _____

NAME OF DRILLING FIRM: *Coast Water Well Service*

NAME & MAILING ADDRESS OF LANDOWNER:
Brian Harvey
Maple Ave
Ocean Springs, Ms

WELL LOCATION: SEC *2* TOWNSHIP *8* RANGE *8*

DISTANCE *2* Miles DIRECTION *SE* NEAREST TOWN *Ocean Springs*

OTHER LANDMARK: _____

WELL PURPOSE: Home, Irrigation, Municipal, Industrial, Fish Pond, etc.

PUMP DATA

PUMP TYPE (Circle One):
Submersible, Turbine, Jet, Flowing Well,
Other (Describe) _____

POWER TYPE (Circle One):
 Electric, Tractor, Diesel, Gasoline, Butane,
Other (Describe) _____ H/P *1*

Pump Capacity (GPM)	No. of Stages	Setting Depth
<i>7.5</i>	<i>2</i>	_____ FT.

PUMP TEST

Well yielded _____ GPM with
a drawdown of _____ ft.
after _____ hours of pumping

WELL DATA

Well Depth <i>171'</i>	Casing Diameter (In) <i>2"</i>	Casing Length (Ft.) <i>161'</i>
Type of Casing <i>PVC</i>	Hole Depth <i>171'</i>	Depth to Static Water Level <i>20'</i>

TYPE OF COMPLETION: (Circle One or More):
 Gravel Packed, Underreamed, Telescoped,
 Natural Development, Open Hole, Other

LOG DATA

TYPE OF LOG RUN (Circle One):
Electric, Gamma Ray, Density, Sonic, Neutron, ~~WB Log Run~~,
Other (Describe) _____

Name of Organization Running Log: _____

WELL GROUTED TO A DEPTH OF *20* FEET

Type Grout (circle one): Cement, Bentonite, or Mix

GEOLOGIC DATA (Office Use Only)

Surface Elev.	Geologic Unit	Unit Thickness	Depth to Top
Subs. SWL	Date	Analysis	Aquifer Test

SCREEN DATA

Diameter - Inches <i>2"</i>	Length - Feet <i>10'</i>	Slot Size - Inches <i>.004</i>
Screen Type <i>PVC</i>	Depth to Bottom - Feet <i>171'</i>	

Driller's Remarks

RECEIVED

Top of _____ Pipe or Reduction in Casing

FEET
10-16-2001

IF TELESCOPED OR MORE THAN ONE SCREEN: USE BACK PAGE

DESCRIPTION OF FORMATIONS ENCOUNTERED	FROM	TO
<i>TOP SOIL</i>	<i>0</i>	<i>2</i>
<i>White coarse Sand</i>	<i>2</i>	<i>10</i>
<i>Blue Clay</i>	<i>10</i>	<i>14</i>
<i>White coarse Sand</i>	<i>14</i>	<i>27</i>
<i>Blue Clay</i>	<i>27</i>	<i>35</i>
<i>Gray coarse Sand</i>	<i>35</i>	<i>87</i>
<i>Blue Clay</i>	<i>87</i>	<i>140</i>
<i>Gray coarse Sand</i>	<i>140</i>	<i>171</i>


FORMATIONS (Continued)	FROM	TO

Dept. of Environmental Quality
Office of Land & Water Resources

IF MORE SPACE IS NEEDED, USE BACK

If well telescopes please
sketch and show depths.

GROUND LEVEL

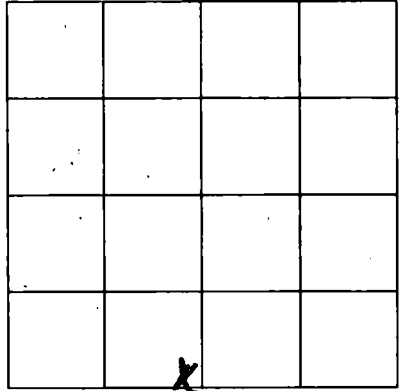

SECTION 2

Please indicate well location X.

ADDITIONAL INFORMATION

If more than one screen,
show location of each on sketch.