

MISSISSIPPI DEPARTMENT OF ENVIRONMENTAL QUALITY

Office of Land and Water Resources

P. O. Box 10631  
Jackson, MS 39289-0631  
WATER WELL DRILLERS LOG

COUNTY WELL LOCATED  
**JACKSON**

WELL NUMBER  
**N-2662**

CODED

DATE WELL COMPLETED  
**9-14-01**

PERMIT NUMBER

NAME OF DRILLING FIRM  
**MTM WELL SERV.**

NAME & MAILING ADDRESS OF LANDOWNER  
**LAURENCE**

**1501 SOUTH 7<sup>th</sup> ST.**

**OCEAN SPRINGS, MS.**

Latitude:

Longitude:

WELL LOCATION. SEC TOWNSHIP RANGE  
**11 8 N 8 E**

DISTANCE DIRECTION NEAREST TOWN  
Miles of

OTHER LANDMARK

WELL PURPOSE: Home, Irrigation, Municipal, Industrial, Fish Pond, etc.

PUMP DATA

PUMP TYPE (Circle One):  
Submersible, Turbine, **Jet** Flowing Well,  
Other (Describe)

POWER TYPE (Circle One):  
**Electric** Tractor, Diesel, Gasoline, Butane,  
Other (Describe) H/P **1**

DESCRIPTION OF FORMATIONS ENCOUNTERED	FROM	TO
<b>SAND</b>	<b>0</b>	<b>76</b>
<b>CLAY (GREY)</b>	<b>76</b>	<b>125</b>
<b>SAND</b>	<b>125</b>	<b>175</b>
<b>CLAY</b>	<b>175</b>	<b>500</b>
<b>SAND</b>	<b>500</b>	<b>510</b>
<b>CLAY</b>	<b>510</b>	<b>570</b>
<b>SAND</b>	<b>570</b>	<b>623</b>

REC'D SEP 27 2001

Top of Lap Pipe or Reduction in Casing

FEET IF TELESCOPED OR MORE THAN ONE SCREEN: USE BACK PAGE

WELL DATA

Well Depth **623** Casing Diameter (in.) **2** Casing Length (Ft.) **613**

Type of Casing **PVC** Hole Depth **623** Depth to Static Water Level **78**

TYPE OF COMPLETION: (Circle One or More):  
**Natural Development**, Gravel Packed, Underreamed, Telescoped,  
Open Hole, Other

WELL GROUTED TO A DEPTH OF **11** FEET

Type Grout (circle one): **Cement**, Bentonite, or Mix

SCREEN DATA

Diameter - Inches **2** Length - Feet **10** Slot Size - Inches **.006**

Screen Type **PVC** Depth to Bottom - Feet **613-623**


I certify that the well was drilled, constructed and completed in accordance with all applicable Requirements of the Mississippi Department of Environmental Quality and/or the Mississippi Department of Health regulations and state laws.

**Alvin M. ...**  
Signature of Licensed Driller and License No.

**9-24-01**  
Date

If well telescopes please sketch and show depths.

GROUND LEVEL

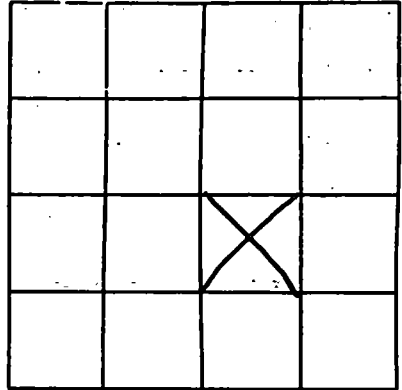

SECTION \_\_\_\_\_

Please indicate well location X.

Pump Capacity (GPM)	No. of Stages	Setting Depth	FT.
---------------------	---------------	---------------	-----

PUMP TEST

Well yielded \_\_\_\_\_ GPM with  
 a drawdown of \_\_\_\_\_ ft.  
 after \_\_\_\_\_ hours of pumping

LOG DATA

TYPE OF LOG RUN (Circle One): No Log Run, Electric, Gamma Ray, Density, Sonic, Neutron, Other (Describe) \_\_\_\_\_

Name of Organization Running Log

GEOLOGIC DATA (Office Use Only)

Surface Elev.	Geologic Unit	Unit Thickness	Depth to Top
Subs. SWL	Date	Analysis	Aquifer Test

Driller's Remarks

If more than one screen, show location of each on sketch.