

MISSISSIPPI DEPARTMENT OF ENVIRONMENTAL QUALITY

Office of Land and Water Resources

P. O. Box 10631
Jackson, MS 39289-0631
WATER WELL DRILLERS LOG

COUNTY WELL LOG # CR03008
WELL NUMBER W-21081 CODED
DATE WELL COMPLETED 11-5-01

PERMIT NUMBER
NAME OF DRILLING FIRM
Coast Water Well Service

NAME & MAILING ADDRESS OF LANDOWNER
Beachview Realty
Porpoise ST
Ocean Springs, MS 39565
Latitude:
Longitude:
WELL LOCATION SEC 11 TOWNSHIP 8 S RANGE 8 W
DISTANCE 2 Miles DIRECTION SE of NEAREST TOWN Ocean Springs
OTHER LANDMARK
WELL PURPOSE: Home, Irrigation, Municipal, Industrial, Fish Pond, etc.

PUMP DATA
PUMP TYPE (Circle One):
Submersible, Turbine, Flowing Well, Other (Describe)
POWER TYPE (Circle One):
 Electric, Tractor, Diesel, Gasoline, Butane, Other (Describe) H/P 1
DESCRIPTION OF FORMATIONS ENCOUNTERED FROM TO
Fill Dirt 0 3
Blue mud 3 12
Coarse Black sand 12 70
Blue Clay w/ str. of Sand 70 135
Medium and Coarse Sand 135 168
REC'D JAN 24 2002
Top of Lap Pipe or Reduction in Casing
FEET IF TELESCOPED OR MORE THAN ONE SCREEN: USE BACK PAGE

WELL DATA
Well Depth 168' Casing Diameter (In.) 2" Casing Length (Ft.) 158'
Type of Casing PVC Hole Depth 168' Depth to Static Water Level 18'
TYPE OF COMPLETION: (Circle One or More):
 Gravel Packed, Underreamed, Telescoped, Natural Development, Open Hole, Other
(Describe)
WELL GROUTED TO A DEPTH OF 10 FEET
Type Grout (circle one): Cement, Bentonite or Mix

SCREEN DATA
Diameter - Inches 2 Length - Feet 10' Slot Size - Inches .008
Screen Type PVC Depth to Bottom, Feet 168'

I certify that the well was drilled, constructed and completed in accordance with all applicable Requirements of the Mississippi Department of Environmental Quality and/or the Mississippi Department of Health regulations and state laws.


Jack Rildell 472
Signature of Licensed Driller and License No.

12-28-01
Date

Additional Information Required On Back

If well telescopes please sketch and show depths.

GROUND LEVEL

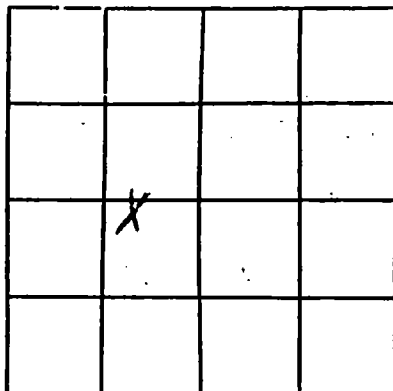

SECTION 11

Please indicate well location X.

Pump Capacity (GPM)	No. of Stages	Setting Depth
<u>9</u>	<u>2</u>	_____ FT.

PUMP TEST

Well yielded _____ GPM with
a drawdown of _____ ft.
after _____ hours of pumping

LOG DATA

TYPE OF LOG RUN (Circle One): No Log Run.
Electric, Gamma Ray, Density, Sonic, Neutron,
Other (Describe) _____

Name of Organization Running Log

GEOLOGIC DATA (Office Use Only)

Surface Elev.	Geologic Unit	Unit Thickness	Depth to Top
Subs. SWL	Date	Analysis	Aquifer Test

Driller's Remarks

If more than one screen,
show location of each on sketch.