

**MISSISSIPPI DEPARTMENT OF ENVIRONMENTAL
QUALITY**

Office of Land and Water Resources

P. O. Box 10631
Jackson, MS 39289-0631
WATER WELL DRILLERS LOG

COUNTY WELL LOCATED
JACKSON

WELL NUMBER CODED
N-2738

DATE WELL COMPLETED
MAY 19 02

PERMIT NUMBER

NAME OF DRILLING FIRM
M + M well

NAME & MAILING ADDRESS OF LANDOWNER
**Carpenter Crest
8108 stephial**

Latitude:
Longitude:

WELL LOCATION. SEC 29 TOWNSHIP 7 RANGE 8
N E

DISTANCE 1/2 MILES DIRECTION South of NEAREST TOWN High 90

OTHER LANDMARK
1/2 mile from school

WELL PURPOSE: Home, Irrigation, Municipal, Industrial, Fish Pond, etc.
Home

PUMP DATA

PUMP TYPE (Circle One):
Submersible, Turbine, Jet Flowing Well,
Other (Describe) _____

POWER TYPE (Circle One):
Electric Tractor, Diesel, Gasoline, Butane,
Other (Describe) _____ H/P 1

DESCRIPTION OF FORMATIONS ENCOUNTERED	FROM	TO
20-40 sand		
20-40 sand		
<u>0-20 clay</u>		
<u>20-120 sand</u>		
<u>120-160 clay</u>		
<u>160-210 sand</u>		

Top of Lap Pipe or Reduction in Casing

FEET IF TELESCOPED OR MORE THAN ONE SCREEN: USE BACK PAGE

WELL DATA

Well Depth 210	Casing Diameter (in.) 2"	Casing Length (Ft.) 200
Type of Casing PVC	Hole Depth 210	Depth to Static Water Level 40

TYPE OF COMPLETION: (Circle One or More):
Natural Development, Gravel Packed, Underreamed, Telescoped,
 Open Hole, Other

WELL GROUTED TO A DEPTH OF 10 FEET
Type Grout (circle one): Cement, Bentonite, or Mix

SCREEN DATA

Diameter - Inches 2"	Length - Feet 10'	Slot Size - Inches 006
Screen Type PVC	Depth to Bottom - Feet 200-210	

I certify that the well was drilled, constructed and completed in accordance with all applicable Requirements of the Mississippi Department of Environmental Quality and/or the Mississippi Department of Health regulations and state laws.


Al Mehall 0563
Signature of Licensed Driller and License No.

July 28, 02
Date

Additional Information Required On Back

If well telescopes please sketch and show depths.

GROUND LEVEL

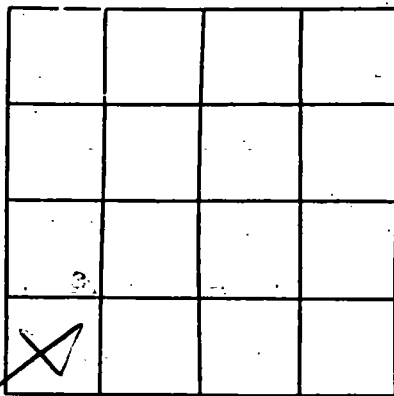

SECTION 29

Please indicate well location X.

Pump Capacity (GPM)	No. of Stages	Setting Depth
<u>8</u>	<u>2</u>	<u>50</u> FT.

PUMP TEST

Well yielded _____ GPM with
a drawdown of _____ ft.
after _____ hours of pumping

LOG DATA

TYPE OF LOG RUN (Circle One): No Log Run,
Electric, Gamma Ray, Density, Sonic, Neutron,
Other (Describe) _____

Name of Organization Running Log _____

GEOLOGIC DATA (Office Use Only)

Surface Elev.	Geologic Unit	Unit Thickness	Depth to Top
Subs. SWL	Date	Analysis	Aquifer Test

Driller's Remarks

If more than one screen,
show location of each on sketch.