

MISSISSIPPI DEPARTMENT OF ENVIRONMENTAL QUALITY

Office of Land and Water Resources

P. O. Box 10631
Jackson, MS 39289-0631
WATER WELL DRILLERS LOG

COUNTY WELL LOCATED <i>Jackson</i>
WELL NUMBER - (CODED) <i>N</i>
DATE WELL COMPLETED <i>3-2-95</i>

PERMIT NUMBER
NAME OF DRILLING FIRM <i>Coast Water Well Service</i>

NAME & MAILING ADDRESS OF LANDOWNER <i>Norman Nommoney</i>		
<i>Deneen Rd.</i>		
<i>Ocean Springs, Ms.</i>		
WELL LOCATION: SEC	TOWNSHIP	RANGE
<i>1</i>	<i>7</i>	<i>9</i>
DISTANCE	DIRECTION	NEAREST TOWN
<i>4</i> Miles	<i>NW</i>	<i>O'Springs</i>
OTHER LANDMARK		
WELL PURPOSE: <input checked="" type="checkbox"/> Home, <input type="checkbox"/> Irrigation, <input type="checkbox"/> Municipal, <input type="checkbox"/> Industrial, <input type="checkbox"/> Fish Pond, etc.		

PUMP DATA		
PUMP TYPE (Circle One): <input checked="" type="checkbox"/> Submersible, <input type="checkbox"/> Turbine, <input type="checkbox"/> Jet, <input type="checkbox"/> Flowing Well, Other (Describe) _____		
POWER TYPE (Circle One): <input checked="" type="checkbox"/> Electric, <input type="checkbox"/> Tractor, <input type="checkbox"/> Diesel, <input type="checkbox"/> Gasoline, <input type="checkbox"/> Butane, Other (Describe) _____ <i>H/P</i>		
Pump Capacity (GPM) <i>10</i>	No. of Stages <i>12</i>	Setting Depth <i>140'</i> FT.
PUMP TEST		
Well yielded _____ GPM with a drawdown of _____ ft. after _____ hours of pumping		

WELL DATA		
Well Depth <i>352'</i>	Casing Diameter (In.) <i>4" x 2"</i>	Casing Length (Ft.) <i>337'</i>
Type of Casing <i>PVC</i>	Hole Depth <i>352'</i>	Depth to Static Water Level <i>100'</i>

LOG DATA	
TYPE OF LOG RUN (Circle One): <input checked="" type="checkbox"/> No Log Run, <input type="checkbox"/> Electric, <input type="checkbox"/> Gamma Ray, <input type="checkbox"/> Density, <input type="checkbox"/> Sonic, <input type="checkbox"/> Neutron, Other (Describe) _____	
Name of Organization Running Log	

TYPE OF COMPLETION: (Circle One or More): <input checked="" type="checkbox"/> Gravel Packed, <input type="checkbox"/> Underreamed, <input type="checkbox"/> Telescoped, <input checked="" type="checkbox"/> Natural Development, <input type="checkbox"/> Open Hole, <input type="checkbox"/> Other (Describe) _____			
WELL GROUTED TO A DEPTH OF <i>20</i> FEET Type Grout (circle one): <input checked="" type="checkbox"/> Cement, <input type="checkbox"/> Bentonite, or <input type="checkbox"/> Mix			

GEOLOGIC DATA (Office Use Only)			
Surface Elev.	Geologic Unit	Unit Thickness	Depth to Top
Subs. SWL	Date	Analysis	Aquifer Test


SCREEN DATA		
Diameter - Inches <i>2"</i>	Length - Feet <i>15'</i>	Slot Size - Inches <i>.004</i>
Screen Type <i>PVC Wrapped</i>	Depth to Bottom - Feet <i>352'</i>	

Driller's Remarks

DESCRIPTION OF FORMATIONS ENCOUNTERED	FROM	TO
<i>Top Soil</i>	<i>0</i>	<i>2</i>
<i>Yellow Clay</i>	<i>2</i>	<i>10</i>
<i>Med-sand</i>	<i>10</i>	<i>20</i>
<i>Blue Clay</i>	<i>20</i>	<i>40</i>
<i>Med-Coars sand</i>	<i>40</i>	<i>90</i>
<i>Blue Clay</i>	<i>90</i>	<i>130</i>
<i>Medium sand</i>	<i>130</i>	<i>145</i>
<i>Blue Clay streaked sand</i>	<i>145</i>	<i>331</i>
<i>Fine Blue sand</i>	<i>331</i>	<i>349</i>
<i>Medium sand</i>	<i>349</i>	<i>352</i>

FORMATIONS (Continued)	FROM	TO
RECEIVED		
APR 10 1995		
Dept. of Environmental Quality Office of Land & Water Resources		
IF MORE SPACE IS NEEDED, USE BACK		

If well telescopes please sketch and show depths.

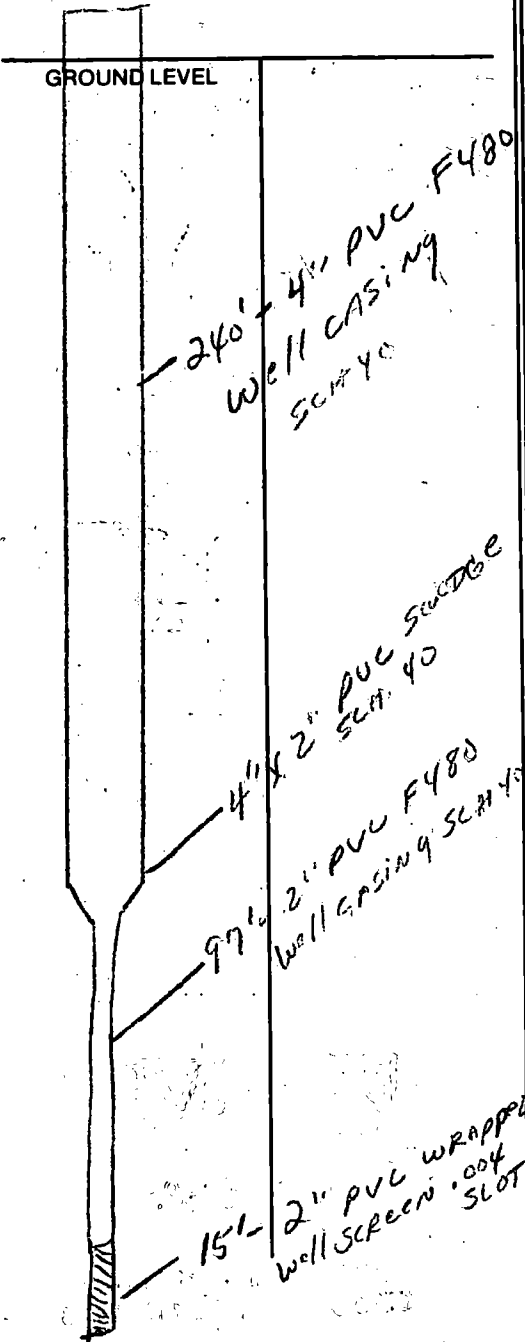

		X	

SECTION 1

Please indicate well location X.

ADDITIONAL INFORMATION

If more than one screen,
show location of each on sketch.