

MISSISSIPPI DEPARTMENT OF ENVIRONMENTAL QUALITY

Office of Land and Water Resources

P. O. Box 10631
Jackson, MS 39289-0631
WATER WELL DRILLERS LOG

COUNTY, WELL LOCATED <i>Jackson</i>
WELL NUMBER (CODED) <i>N</i>
DATE WELL COMPLETED <i>10-19-94</i>

PERMIT NUMBER
NAME OF DRILLING FIRM <i>Coast Water Well Service</i>

NAME & MAILING ADDRESS OF LANDOWNER <i>Danny McMain Noble Rd. Ocean Springs, Ms.</i>			
WELL LOCATION	SEC	TOWNSHIP	RANGE
<i>E112</i>	<i>11</i>	<i>8 N</i>	<i>8 E</i>
DISTANCE	DIRECTION	NEAREST TOWN	
<i>4</i> Miles	<i>SE</i>	<i>OCEAN SPRINGS</i>	
OTHER LANDMARK			
WELL PURPOSE (Home, Irrigation, Municipal, Industrial, Fish Pond, etc.) <i>Home</i>			

PUMP DATA		
PUMP TYPE (Circle One): <input checked="" type="radio"/> Submersible Turbine, <input type="radio"/> Flowing Well, Other (Describe) _____		
POWER TYPE (Circle One): <input checked="" type="radio"/> Electric Tractor, Diesel, Gasoline, Butane, Other (Describe) _____ H/P <i>1</i>		
Pump Capacity (GPM)	No. of Stages	Setting Depth
<i>20</i>	<i>11</i>	<i>100</i> FT.
PUMP TEST		
Well yielded _____ GPM with a drawdown of _____ ft. after _____ hours of pumping		

WELL DATA		
Well Depth	Casing Diameter (In)	Casing Length (Ft)
<i>360'</i>	<i>4x2</i>	<i>340'</i>
Type of Casing	Hole Depth	Depth to Static Water Level
<i>PVC</i>	<i>360'</i>	<i>50'</i>
TYPE OF COMPLETION: (Circle One or More): <input checked="" type="checkbox"/> Gravel Packed, <input type="checkbox"/> Underreamed, <input type="checkbox"/> Telescoped, <input checked="" type="checkbox"/> Natural Development, <input type="checkbox"/> Open Hole, <input type="checkbox"/> Other (Describe) _____		

LOG DATA	
TYPE OF LOG RUN (Circle One): <input checked="" type="radio"/> No Log Run, Electric, Gamma Ray, Density, Sonic, Neutron, Other (Describe) _____	
Name of Organization Running Log	

WELL GROUTED TO A DEPTH OF <i>20</i> FEET
Type Grout (circle one): Cement, Bentonite, or Mix

GEOLOGIC DATA (Office Use Only)			
Surface Elev.	Geologic Unit	Unit Thickness	Depth to Top
Subs SWL	Date	Analysis	Aquifer Test

SCREEN DATA		
Diameter - Inches	Length - Feet	Slot Size - Inches
<i>2"</i>	<i>20'</i>	<i>.004</i>
Screen Type	Depth to Bottom - Feet	
<i>PVC wrapped</i>	<i>360'</i>	


Driller's Remarks
Top of Lap Pipe or Reduction in Casing
FEET <input type="checkbox"/> IF TELESCOPED OR MORE THAN ONE SCREEN: USE BACK PAGE

DESCRIPTION OF FORMATIONS ENCOUNTERED	FROM	TO	FORMATIONS (Continued)	FROM	TO
<i>Coarse sand shell</i>	<i>0</i>	<i>80</i>	RECEIVED NOV 10 1994		
<i>Blue clay trap clay</i>	<i>80</i>	<i>185</i>			
<i>Medium sand</i>	<i>185</i>	<i>197</i>			
<i>Blue clay</i>	<i>197</i>	<i>230</i>			
<i>fine sand</i>	<i>230</i>	<i>245</i>			
<i>Blue clay</i>	<i>245</i>	<i>298</i>			
<i>Medium sand</i>	<i>298</i>	<i>308</i>			
<i>Blue clay</i>	<i>308</i>	<i>340</i>			
<i>Medium sand</i>	<i>340</i>	<i>360</i>			

IF MORE SPACE IS NEEDED USE BACK

If well telescopes please sketch and show depths.

GROUND LEVEL

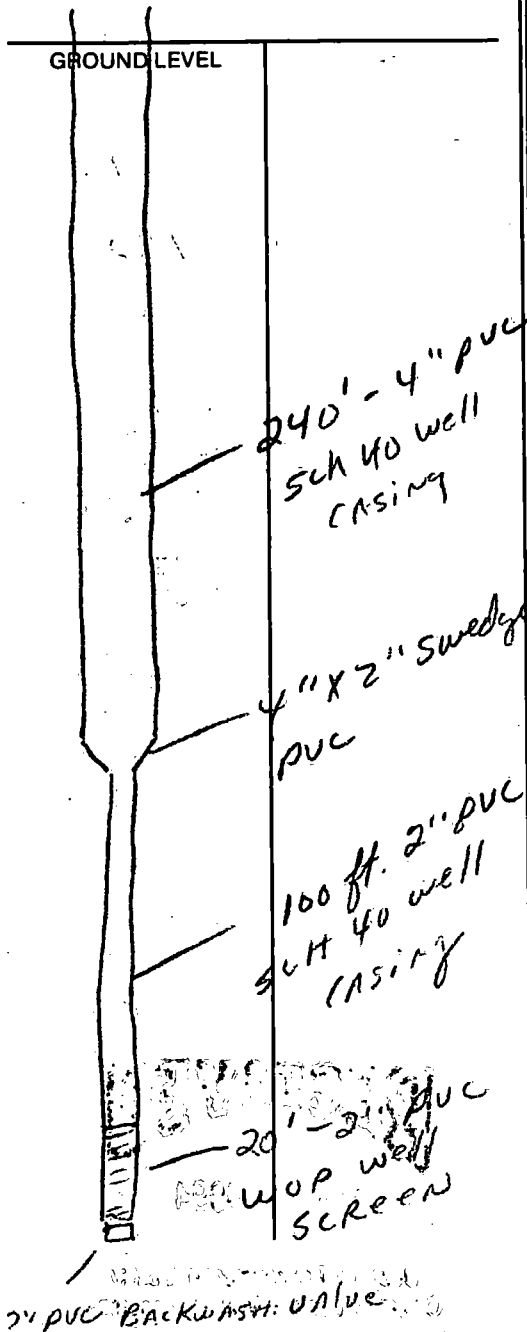

			X

SECTION 11

Please indicate well location X.

ADDITIONAL INFORMATION

If more than one screen, show location of each on sketch.