

JACKSON

MISSISSIPPI BOARD OF WATER COMMISSIONERS

285, 296, 3060, 3075 4070 4079

N1

1-65

WATER WELL DRILLERS LOG

CODED

Date: 1-17-65, 19, Driller: C. T. Lutzew Well Co County Jackson

(Name)

(1) Owner of Land: Upton R. Gentine  
(Name)  
Cedar Grove Sub-div.  
(Address)

(2) Location: 1/4, 1/4, Sec. 10 T7R9  
(distance) miles (direction) of (Nearest Town)

(3) Topography: \_\_\_\_\_  
(Hilly) (Flat) (Level)

(4) Purpose of Well: Commercial  
(Domestic Irrigation  
Municipal, Industrial, Other)

Description & Color of Materials Sand, Clay, Red Clay, Shell, etc.	Thick- ness Feet.	Depth Feet
Sand	0	18
Clay	18	42
Sand	42	118
Clay	118	220
Sand	220	240
Clay	240	280
Sand	480	496
Clay	496	560
Sand, good	560	610
Shell & sand	610	628
Clay	628	706
Sand, fine	706	744
Sand, good	744	766
Fine sand & clay	766	812
Sand, good	812	842
Clay	842	844
Sand, good	844	864
Clay	864	916

Information upon completion of well:

(1) Diameter 4x6 inches.

(2) Total Depth 864 feet.

(3) Water Level 12' - feet below top of ground.  
top 129' - 6"

(4) Cased to 864, Size 4x6"

(5) Screen: Size 8 gas, Length 60'


(6) Were any formations sealed against pollution?  
X yes, \_\_\_\_\_ no.

If YES depth of formation \_\_\_\_\_

Why Health Dept Agreement

Drillers Remarks:

CODED

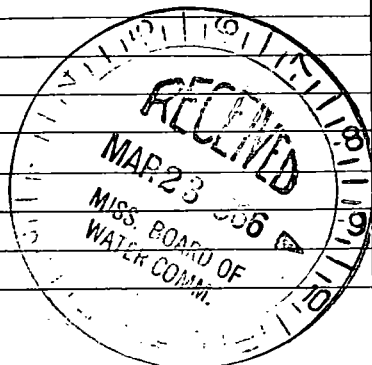

(Use Back Side)

Well No.

