

WATER WELL DRILLERS LOG

7-8-60

Date: July 8, 1960, Driller: C. J. Switzer Well Co. County Jackson  
 (Name)

(1) Owner of Land: Howard Pearson  
North West of Ocean Springs  
on Vandevere Road  
 (Address)

(2) Location: SE 1/4, SW 1/4, Sec. 8 T 75 R 7  
6 miles N.W., of Ocean Springs  
 (distance) (direction) (Nearest Town)

(3) Topography:  (Hilly)  (Flat)  (Level)

(4) Purpose of Well: Domestic  
 (Domestic Irrigation, Municipal, Industrial, Other)

Description & Color of Materials Sand, Clay, Red Clay, Shell, etc.	Thick- ness Feet	Depth Feet
<u>Red surface clay</u>	<u>22</u>	<u>22</u>
<u>sand and gravel</u>	<u>58</u>	<u>80</u>
<u>Blue clay</u>	<u>93</u>	<u>173</u>
<u>sand - coarse</u>	<u>30</u>	<u>203</u>

Information upon completion of well:

(1) Diameter 2 inches.

(2) Total Depth 203 feet.

(3) Water Level 21' feet below top of ground.

(4) Cased to 203', Size 2"


(5) Screen: Size 010.00, Length 10 feet

(6) Were any formations sealed against pollution?  
 yes,  no.

If YES depth of formation 10 feet

Why Health Dept. requirement

Drillers Remarks:

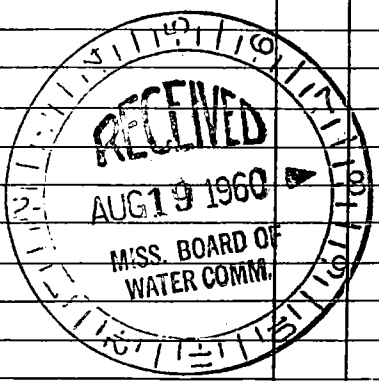

(Use Back Side)

Well No.

