

# JACKSON MISSISSIPPI BOARD OF WATER COMMISSIONERS

050

6-2-61

## WATER WELL DRILLERS LOG

050

~~034~~

Date: June 2, 1961, Driller: L.P. Garland County Jackson  
 (Name)

(1) Owner of Land: Texaco  
 (Name)

(Address)

(2) Location: SW 1/4, SW 1/4, Sec 36 T7 S R7 W  
3 miles West of Hautier  
 (distance) (direction) (Nearest Town)

(3) Topography: \_\_\_\_\_  
 (Hilly) (Flat) (Level)

(4) Purpose of Well: Municipal  
 (Domestic Irrigation) (Municipal, Industrial) (Other)

| Description & Color of Materials<br>Sand, Clay, Red Clay, Shell, etc. | Thick-<br>ness<br>Feet | Depth<br>Feet |
|---|------------------------|---------------|
| <u>Pulled old well</u>  |                        | <u>210'</u>   |
| <u>10' Sand 11' Mud</u>   |                        | <u>231</u>    |
| <u>Fine Sand</u>  |                        | <u>252</u>    |
| <u>" "</u>  |                        | <u>273</u>    |
| <u>19' Sand 2' Mud</u>  |                        | <u>294</u>    |
| <u>Mud</u>  |                        | <u>315</u>    |
| <u>"</u>  |                        | <u>336</u>    |
| <u>"</u>  |                        | <u>357</u>    |
| <u>Mud &amp; Sand Strk.</u>   |                        | <u>378</u>    |
| <u>Mud &amp; Shale</u>  |                        | <u>399</u>    |
| <u>" "</u>  |                        | <u>420</u>    |
| <u>Sand &amp; Mud Strk.</u>   |                        | <u>441</u>    |
| <u>Mud &amp; Shale</u>  |                        | <u>462</u>    |
| <u>Sand</u>   |                        | <u>483</u>    |
| <u>"</u>  |                        | <u>504</u>    |
| <u>13' Sand (Good)</u>  |                        | <u>517</u>    |

Information upon completion of well:

(1) Diameter 2 inches.

(2) Total Depth 517 feet.

(3) Water Level \_\_\_\_\_ feet below top of ground.


(4) Cased to \_\_\_\_\_, Size \_\_\_\_\_

(5) Screen: Size .08, Length \_\_\_\_\_

(6) Were any formations sealed against pollution?  
 \_\_\_\_\_ yes, \_\_\_\_\_ no.

If YES depth of formation \_\_\_\_\_  
 Why \_\_\_\_\_

Drillers Remarks: \_\_\_\_\_

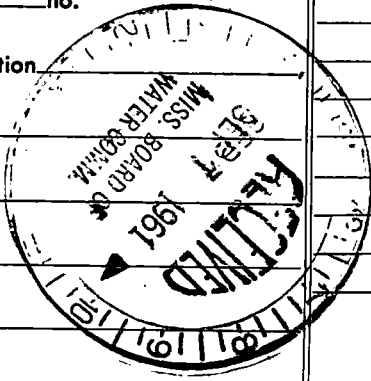

(Use Back Side)

Well No.

1000



100